



Harvey KANSAS

Section **31** Township **23** Range **3W**

Well Number **#1 Schrag**

Company **Tom Palmer**

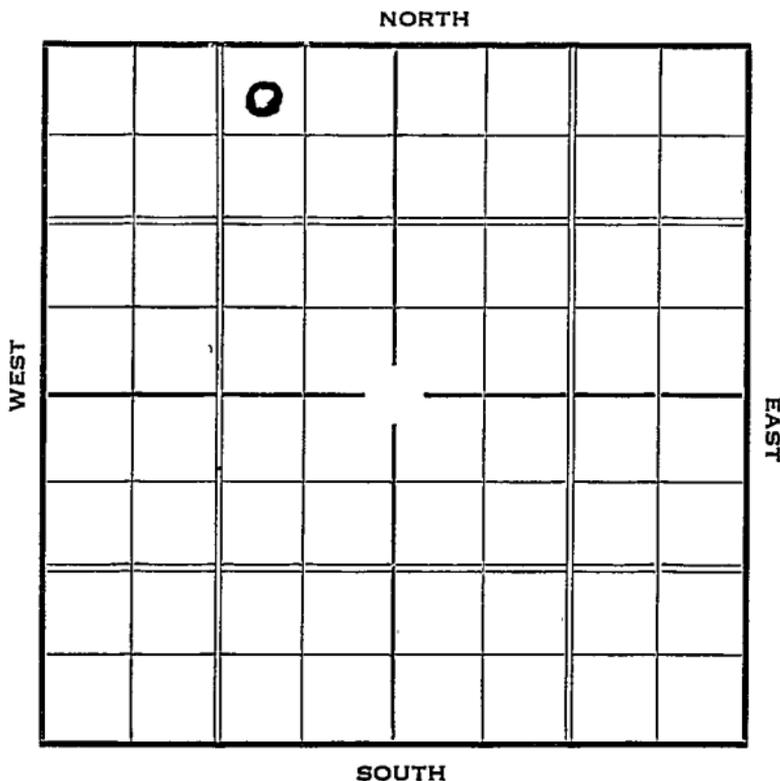

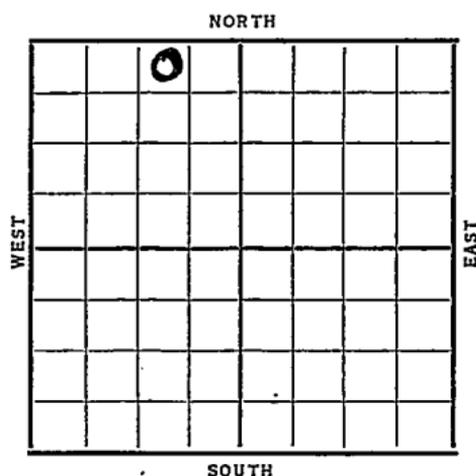Sec. 31 Twp. 23 R. 3-WWell No. #1 Schrag FarmTom Palmer Company330' Ft. from N. Line Ft. from S. Line890' Ft. from E. Line Ft. from W. Line

| Date | REPORT |
|------|-------------------------------|
| 1937 | |
| 7/7 | Location |
| 7/16 | R. R. |
| 7/23 | 10" @ 268'. WOC. |
| 7/30 | Drlg. 1667'. |
| 8/6 | Drlg. 2980'. |
| 8/13 | Chat 3257'. 7" @ 3279'. |
| | S. G. 3283'. T.D. 3285'. C.O. |
| | |
| 8/18 | 7" @ 3279'. |
| | Chat: 3257'. |
| | T.D. 3368'. |
| | 3000 acid. |
| | Flowed 134 bbls. 4 hrs. |
| | 144 bbls. 4 hrs. |
| | Pot. 804 bbls. |
| | COMPLETED |
| | |
| | |
| | |

Harvey **KANSAS**

Map No. _____ Sec. 31 Twp. 23R. 3W

Well No. 1-Schrag

Tom Palmer Company

Contractor

FIRST REPORT

Texas Farm out
SECTION PLAT

530 Ft. from N. Line

_____ Ft. from S. Line

990 Ft. from E. Line

_____ Ft. from W. Line

| | | | |
|--|---|--|--|
| | 0 | | |
| | | | |
| | | | |
| | | | |

Location _____

Rig up _____

Drilling and Remarks:

RECORD

Cased _____ in., _____ ft.

Sand _____

Gas _____

Oil _____

Total Depth _____

PRODUCTION

1st 24 hrs. Nat. _____

1st 24 hrs. after shot _____

Gas _____ Cu. Ft.

Dry Hole _____

Abandoned _____

Date
JUL 7 1937

H. D. Hatfield
Scout

Harvey **KANSAS**

Map No. _____ Sec. 51 Twp. 23 R. 3W

Well No. 1 - Schragg

Tom Palmer Company

Contractor

COMPLETED

SECTION PLAT

330 Ft. from N. Line
 _____ Ft. from S. Line
990 Ft. from E. Line
 _____ Ft. from W. Line

| | | | |
|--|---|--|--|
| | 0 | | |
| | | | |
| | | | |
| | | | |

RECORD

Location _____

Cased 7 in., 3279 ft.

Rig up _____

Sand Chat 3257

Drilling and Remarks:

Gas _____

*3000 acid
 flowed 13 4/4
 14 4/4
 Pot - 804*

Oil _____

Total Depth 3368

PRODUCTION

1st 24 hrs. Nat. _____

1st 24 hrs. after shot _____

Gas _____ Cu. Ft.

Dry Hole _____

Abandoned _____

Date

AUG 18 1937 19

H. D. Hatfield Scout