


Section 31 Township 23 Range 3-W

Well No. 2 - Schrag

Company Palmer

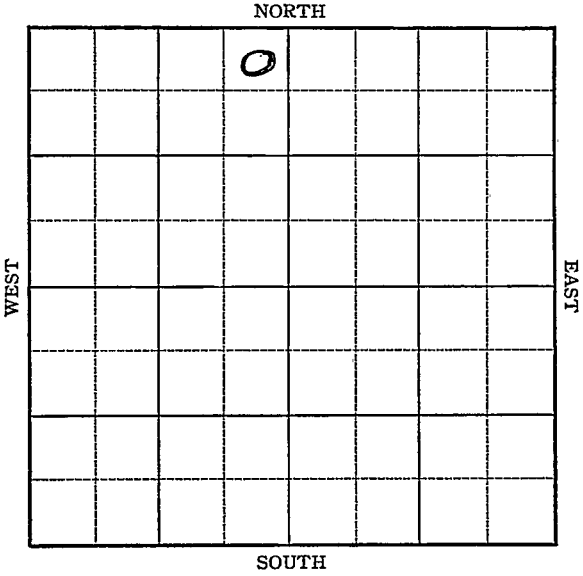

Sec. 31 Twp. 23 R. 3-W


Well No. #2 Schrag Farm  
Palmer Company

330 Ft. from N. Line

\_\_\_\_\_ Ft. from S. Line

330 Ft. from E. Line

\_\_\_\_\_ Ft. from W. Line

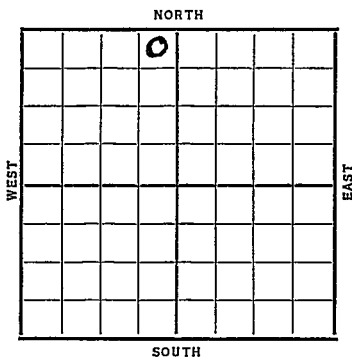

| Date | REPORT                   |
|------|--------------------------|
| 1937 |                          |
| 9/1  | B.R.R.                   |
| 9/10 | R. U. R.                 |
| 9/17 | 10" @ 275'. Drlg. 1370'. |
| 9/24 | Drlg. 2810'.             |
| 10/2 | Chat 3265'. T.D. 3287'.  |
|      | 7" @ 3285'. No shows     |
|      | reported.                |
|      |                          |
| 10/6 | 7" @ 3285'.              |
|      | Chat 3265'.              |
|      | T.D. 3358'.              |
|      | 2000 acid.               |
|      | Pot. 764 bbls. flowing.  |
|      | COMPLETED                |
|      |                          |
|      |                          |
*Harvey* **KANSAS**

Map No. \_\_\_\_\_ Sec. 31 Twp. 23 R. 3W

Well No. 2 - Schrag

Palmer Company

Contractor \_\_\_\_\_

**FIRST REPORT**

**SECTION PLAT**

330 Ft. from N. Line

\_\_\_\_\_ Ft. from S. Line

330 Ft. from E. Line

\_\_\_\_\_ Ft. from W. Line

|  |  |   |  |
|--|--|---|--|
|  |  | 0 |  |
|  |  |   |  |
|  |  |   |  |
|  |  |   |  |

Location \_\_\_\_\_

Rig up \_\_\_\_\_

Drilling and Remarks:

*BBR*

**RECORD**

Cased \_\_\_\_\_ in., \_\_\_\_\_ ft.

Sand \_\_\_\_\_

Gas \_\_\_\_\_

Oil \_\_\_\_\_

Total Depth \_\_\_\_\_

**PRODUCTION**

1st 24 hrs. Nat. \_\_\_\_\_

1st 24 hrs. after shot \_\_\_\_\_

Gas \_\_\_\_\_ Cu. Ft.

Dry Hole \_\_\_\_\_

Abandoned \_\_\_\_\_

Date

SEP 1 1937

H. D. Hatfield Scout

Harvey **KANSAS**Map No. \_\_\_\_\_ Sec. 31 Twp. 23 R. 3WWell No. 2 SchragPalmer

Company \_\_\_\_\_

Contractor \_\_\_\_\_

~~COMPLETED~~

## SECTION PLAT

NE NW

330\* Ft. from N. Line

\_\_\_\_\_ Ft. from S. Line

330 Ft. from E. Line

\_\_\_\_\_ Ft. from W. Line

|  |   |  |  |
|--|---|--|--|
|  | 0 |  |  |
|  |   |  |  |
|  |   |  |  |
|  |   |  |  |

Location \_\_\_\_\_

Rig up \_\_\_\_\_

Drilling and Remarks:

2000 ACIDPOT - 764Flowing

## RECORD

Cased 7 in., 3285 ft.Sand Chat 3265

Gas \_\_\_\_\_

Oil \_\_\_\_\_

Total Depth 3358

## PRODUCTION

1st 24 hrs. Nat. \_\_\_\_\_

1st 24 hrs. after shot \_\_\_\_\_

Gas \_\_\_\_\_ Cu. Ft.

Dry Hole \_\_\_\_\_

Abandoned \_\_\_\_\_

Date

OCT - 6 1937

19

H. D. Hatfield

Scout