

KANSAS

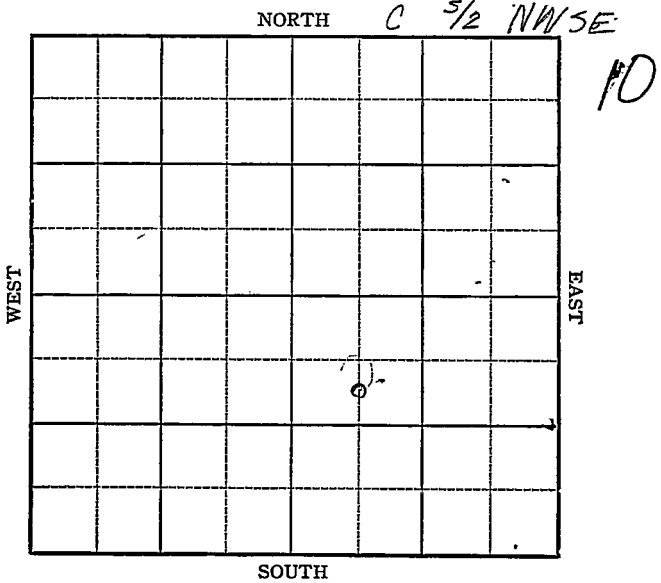
Reno

FORM 51 5M PETROL

Section 31 Township 23 Range 10 W

Well No. #4 Johnson

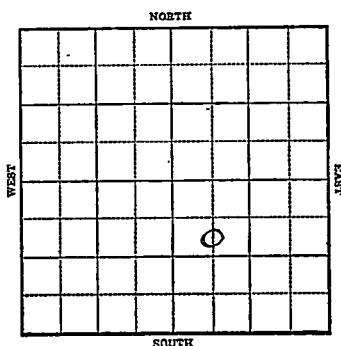
Company Stanolind



1803

KANSAS

Reno

Sec. 31 Twp. 23 R. 10-WWell No. #4 Johnson FarmStanolind Company990 Ft. from N. Line Ft. from S. Line Ft. from E. Line660 Ft. from W. Line

1943

E. 1803 L5 R E P O R T

12/1

8" @ 265

WOG.

12/8

Drlg. 2390'

12-15

Drlg. 3310'

12/22

Viola 3704

SSO 3709-16

TD 3619

12/29

TD 3733

5" @ 3728 RUST

1944

1-5

"

"

1-12

TD 3772 SO & W

1/19

TD 3804

PB 3740

8000 acid

Testing.

1/26

5" @ 3729

Viola 3704

TD 3804

PB 3740

800 acid

Pump 247 Pot.

Gravity 42

COMPLETED

KANSAS

Map No. 47 Sec. 31 Twp. 23 R. 10WWell No. 4 Johnson

Stanolind

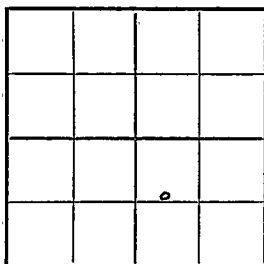
Company

FIRST REPORT

Contractor

C S L NW SE

SECTION PLAT

990 Ft. from N. Line

_____ Ft. from S. Line

_____ Ft. from E. Line

660 Ft. from W. Line

Peace Creek Pool

Location _____

Rig up _____

Drilling and Remarks:

8" $\approx$ 265 WOC

RECORD

Cased _____ in., _____ ft.

Sand _____

Gas _____

Oil _____

Total Depth _____

PRODUCTION

1st 24 hrs. Nat. _____

1st 24 hrs. after shot _____

Gas _____ Cu. Ft.

Dry Hole _____

Abandoned _____

Date

DEC 1 1943 19

S. J. LEWIS

Scout

KANSAS

Map No. 47 Sec. 31 Twp. 23 R. 10WWell No. 4 JohnsonStanolind

Company

COMPLETED

Contractor

C S L NW SE

SECTION PLAT

990

Ft. from N. Line

Ft. from S. Line

Ft. from E. Line

660

Ft. from W. Line

		o	

Peace Creek Pool

Location

Rig up

Drilling and Remarks:


RECORD

Cased ✓ in., _____ ft.

Sand _____

Gas _____

Oil _____

Total Depth 3804

PRODUCTION

1st 24 hrs. Nat. _____

1st 24 hrs. after shot _____

Gas _____ Cu. Ft.

Dry Hole _____

Abandoned _____

Date

JAN 26 1944 19S. J. LEWIS

Scout