

KANSAS


FORM 51 5M PETROL

Reno

Section 31 Township 23 Range 10W

Well No. #4 Johnson

Company Sekly

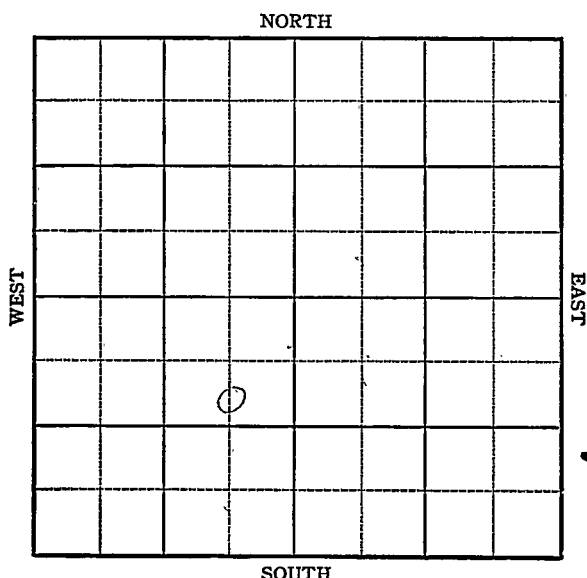

Pool Name Zenith

KANSAS 7
 Map No. 31 Sec. 23 Twp. 10W

Well No. 4 Johnson

Skelly

Company

FIRST REPORT

Contractor

C S L NE SW

SECTION PLAT

990 Ft. from N. Line Ft. from S. Line660 Ft. from E. Line Ft. from W. Line

Reno County

Location XRig up

Drilling and Remarks:

RECORD

Cased in., ft.Sand Gas Oil Total Depth

PRODUCTION

1st 24 hrs. Nat. 1st 24 hrs. after shot °Gas Cu. Ft.Dry Hole Abandoned

Date

MAY 17 1944 19

S. J. LEWIS Scout

Pool Name Zenith
 Map No. 47 Sec. 31 Twp. 23 R. 10W
 Well No. 4 Johnson

Skelly Company

COMPLETED Contractor
C S L NE SW

SECTION PLAT

990 Ft. from N. Line

 Ft. from S. Line

660 Ft. from E. Line

 Ft. from W. Line

	6		

Reno County

Location

Rig up

Drilling and Remarks:

Vista 3685

5" C3709

1000 acro V

Borny B2 3323

May 3000

42° SW

RECORD

Cased in., ft.

Sand

Gas

Oil

Total Depth 3237

PRODUCTION

1st 24 hrs. Nat.

1st 24 hrs. after shot

Gas Cu. Ft.

Dry Hole

Abandoned

Date

JUL 12 1944

19

S. J. LEWIS Scout