

KANSAS


Reno

FORM 51 5M 1-42 PETROL

Section 31 Township 23 Range 10-W

Well No. #1 Ira Johnson

Company Skelly Oil

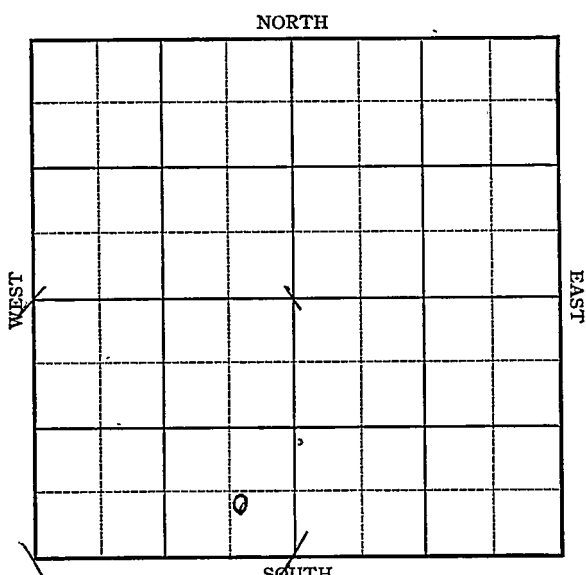

KANSAS

Reno

Sec. 31 Twp. 23 R. 10-W

Well No #1 Ira Johnson Farm

Skelly Oil Company

Zenith


 Ft. from N. Line

554 Ft. from S. Line

554 Ft. from E. Line

 Ft. from W. Line

Elev. 1807

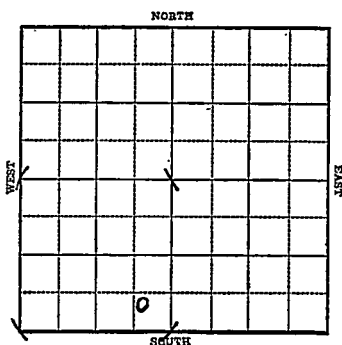

1943

R E P O R T

4/21 ^{mi}oving in Rig.

4/28 10" @ 272' WOC.

5/5 Drlg. 2550'

5/12 Lans 3304

Misener 3679

Viola 3684

T.D. 3707

6" @ 3707 Rust.

5/19 T.D. 3725

Flow 15 oil per hr.

5/26 Viola 3684

6" @ 3707'

T.D. 3725'

Pump & flow 174 Pot. ?

Gravity 42

COMPLETED


Reno

~~KANSAS~~Map No. 4 Sec. 31 Twp. .23 R. 10WWell No. 1 Ira JohnsonSkelly oil CompanyFIRST REPORT Contractor

C SE SW

 Ft. from N. Line554 Ft. from S. Line554 Ft. from E. Line Ft. from W. Line

SECTION PLAT

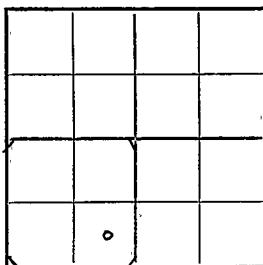

ZENITH POOL

Location Rig up

Drilling and Remarks:

Moving in Rig

RECORD

Cased in., ft.Sand Gas Oil Total Depth

PRODUCTION

1st 24 hrs. Nat. 1st 24 hrs. after shot Gas Cu. Ft.Dry Hole Abandoned

Date

APR 21 1943 19 S. J. LEWIS Scout

Map No. 47 Sec. 31 Twp. 23 R. 10WWell No. 1 Ira JohnsonSkelly Oil

Company

COMPLETED

Contractor

C SE SW

SECTION PLAT

_____ Ft. from N. Line

554 Ft. from S. Line554 Ft. from E. Line

_____ Ft. from W. Line

ZENITH POOL

Location _____

Rig up _____

Drilling and Remarks:

*Vista 3684**6" @ 3707**Pump & Flow**74 P.D.**42 e Gr*

RECORD

Cased _____ in., _____ ft.

Sand _____

Gas _____

Oil _____

Total Depth 3725

PRODUCTION

1st 24 hrs. Nat. _____

1st 24 hrs. after shot _____

Gas _____ Cu. Ft.

Dry Hole _____

Abandoned _____

Date

MAY 26 1943 19

S. J. LEWIS

Scout