

KANSAS

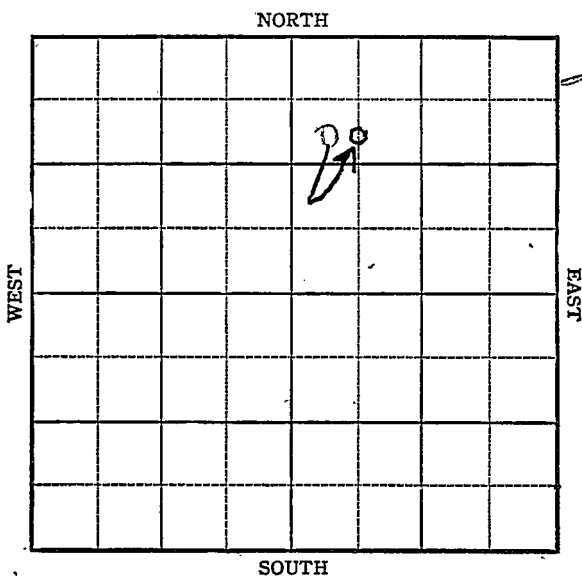
Reno

FORM 51 5M BR1X

Section 31 Township 23 Range 10W

Well No. #18 Ira Johnson

Company Stanölinö



KANSAS

Special
Reno County

Sec. 31 Twp. 23 R. 10W

Well No. #8 Ira Johnson Farm

Stanolind *Hartnett* Company
Zenith *Lease*

990 Ft. from N. Line

 Ft. from S. Line

 Ft. from E. Line

660
330 Ft. from W. Line

SW NW NE *Elev. 1801* SOUTH

1944	REPORT
12/13	Derrick
12-19	"
<u>1945</u>	
<u>1/3</u>	"
1/10	"
1-17	13" @ 180' Drilling 1940'
1-24	Drilling 3485'
1-31	Misenner 3677'
	Viola 3678'-80'
	Total Depth 36'80'
	Running casing.
2-7	Set 5" @ 3768'
	Rigging up standard tools.
2-14	Perforated 20 shots 3706-13' No shows
	Perforated 20 shots 3114-20' No shows
	Acidized with 2000 gallons.
2-21	Flowed 60 bbl. oil 1st hour.
	" 54 bbl. oil 2nd hour, thru
	2 $\frac{1}{2}$ " tubing - 1" choke.
2/28	Viola $\frac{1}{2}$ 3678 5" @ 3768 Perf. Viola 2000 acid TD 3770 Bomb Pot. 6822 Max. 3000 Grav. 42.0

COMPLETED

Pool Name ZenithMap No. 47 Sec. 31 Twp. 23 R. 10WWell No. 8 Ira JohnsonStanolind

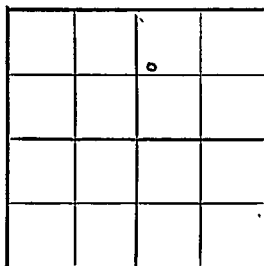
Company

FIRST REPORT

Contractor

SW NW NE

SECTION PLAT

990 Ft. from N. Line Ft. from S. Line Ft. from E. Line330 Ft. from W. LineRenoLocation Rig up

Drilling and Remarks:

derrick*Hot File*

RECORD

Cased in., ft.Sand Gas Oil Total Depth

PRODUCTION

1st 24 hrs. Nat. 1st 24 hrs. after shot Gas Cu. Ft.Dry Hole Abandoned

Date

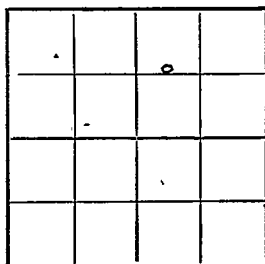
DEC 13 1944.19S. J. LEWIS

Scout

Pool Name ZenithMap No. 47 Sec. 31 Twp. 23 R. 10WWell No. 8 Ira JohnsonStanolind CompanyCOMPLETEL Contractor

C S L NW NE

SECTION PLAT

990 Ft. from N. Line Ft. from S. Line Ft. from E. Line660 Ft. from W. LineRenoLocation Rig up

Drilling and Remarks:

Via 36785" 3768Pay via2000 acBore 4876822Max 30004200

RECORD

Cased in., ft.Sand Gas Oil Total Depth: 3770

PRODUCTION

1st 24 hrs. Nat. 1st 24 hrs. after shot Gas Cu. Ft.Dry Hole Abandoned

Date

FEB 28 1945 19

S. J. LEWIS Scout