

Stafford

DX 78-1

KANSAS

Section 31 Township 23 Range 14W

Well No. #1 Hohner

Company ~~Teklan~~ Lee Phillips

NORTH

WEST								
	0							

EAST

SOUTH

Stafford

KANSAS

SEC.	TWP.	R.
31	23	14 W 1
WELL NO.		
# 1 Hohner		FARM
COMPANY		
Lee Phillips		
Toklan		
CONTRACTOR		

Wildcat

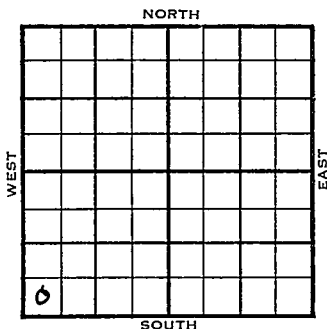
Ft. from N. Line

330 Ft. from S. Line

Ft. from E. Line

330 Ft. from W. Line

SW SW SW



Sunray - DHM

ELEVATION

REPORT

1954

1991'

5/12 Location

5/26 2

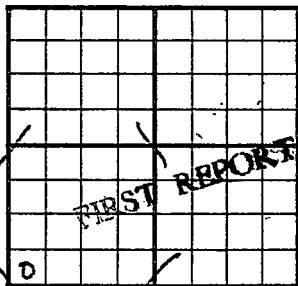
6/2 "

6/9 "

7/7 8" @ 200

7/21 Spud 7-6-54 D & A TD 4160
 8" @ 200 Heeb 3525' Tor. 3545'
 Br. line 3659 Lans 3674 Cong 4023
 Viola 4033 Simp. 4077 Arb. 4123
 TD 4160' D & A

ABANDONED

County Stafford State KansasSec. 31 (Blk. Twp.) 23 (Sur. Rge.) 14W Map No.Operator ToklanWell No. 1 Farm HohnerElev. Location SW SW SW330 Ft. From S Line SW330 Ft. From FF Line Quarter1st. Report MAY 12 1954

Completion

Remarks Sunray - DHM

Spudding Date

Drlg. Data WildcatLocation

Kansas

Map No. _____ Sec. 31 Twp. 23 R. 14WWell No. 1 Hohner._____Lee Phillips_____
Company_____**CORRECTION**_____
Contractor

SW SW SW

SECTION PLAT

0			

_____Ft. from N. Line330 _____
Ft. from S. Line_____Ft. from E. Line330 _____
Ft. from W. Line_____Stafford County_____

Location _____

Rig up _____

Drilling and Remarks:

Reported

Toklan Oil

RECORD

Cased _____ in., _____ ft.

Sand _____

Gas _____

Oil _____

Total Depth _____

PRODUCTION

1st 24 hrs. Nat. _____

1st 24 hrs. after shot _____

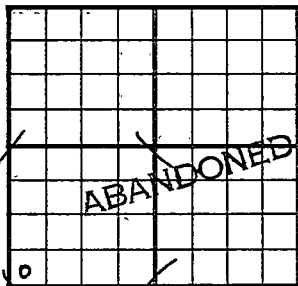
Gas _____ Cu. Ft.

Dry Hole _____

Abandoned _____

Date

JUN 23 1954 19J. G. McGEHEE Scout

County Stafford State KansasSec. 31 (Blk. Twp.) 23 (Sur. Rge.) 14W Map No.Operator Lee PhillipsWell No. 1 Farm HohnerElev. 1991 Location SW SW SW330 Ft. From S Line SW330 Ft. From W Line Quarter

1st. Report

Completion JUL 21 1954Remarks WildcatSpudding Date 7-6-54Drlg. Data D & A TD 41608" @ 200 Heeb. 3525 Tor. 3545Br. lime 3659 Lans. 3674 Cong. 4023Viola 4033 Simp. 4077 Arb. 4123TD 4160D & A