


Section 31 Township 23 Range 15W

Well No. 5 Gano

Company Lion Oil

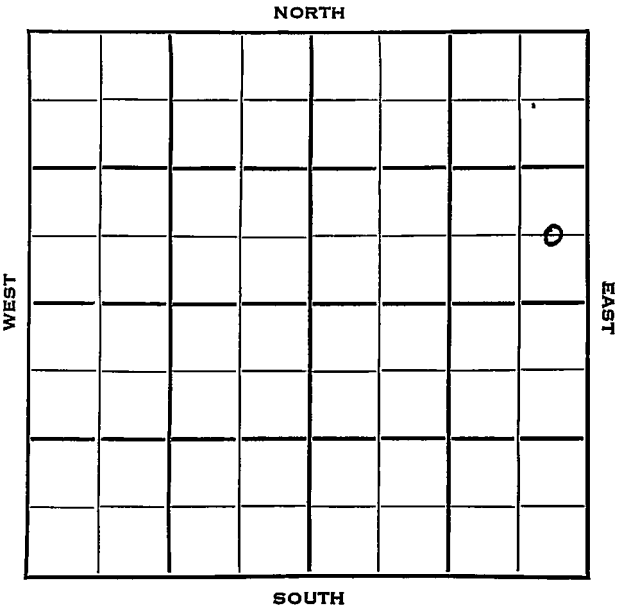

Pawnee KANSAS

SEC.	TWP.	R.
31	23	15W ✓

WELL NO.

5 Gano

FARM

COMPANY

Lion Oil

CONTRACTOR

Garvey

Benson Pool

Ft. from N. Line


660

Ft. from S. Line

330

Ft. from E. Line

Ft. from W. Line

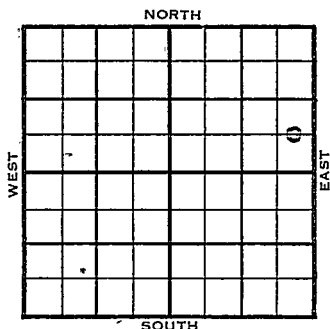

C E L S E N E

	ELEVATION	REPORT
1954	2044'	
2/3	Spud 1-27-54 8" @ 275' Drlg. 3585'	
2/10	Heeb 3477', Br. L. 3604', Lans 3612' DST 3607'-34' 1 hr, 510' gas, 90' O&GCM. DST 3631'-75' 1 hr, 30' M 990# DST 3738'-78' 1 hr, 1090' gas, 110' O&GCM, 360# DST 3785'-3830' 1 hr, 180' gas, 46' O&GCM, 200# RTD 3901 Schl 5" @ 3898' C.O. 3875 12/ 3850-54 1000 A 20 gwph P.B. 3825	

OVER

1954
3/10

Spud 1-27-54

Oil Well

TD 3901'

8" @ 275'

Heeb 3477', Br lime 3604', Lans 3612'

DST 3607-34, opn 1 hr., rec. 510' gas,
90' o & gcm

DST 3631-75', opn 1 hr., rec. 30' mud,
990#

DST 3738-78', opn 1 hr., rec. 1090'
gas, 110' o & gcm, 360#

DST 3785-3830', opn 1 hr., rec. 180'
gas, 46' o. & gcm, 200#

TD 3901'

5" @ 3898'

CO to 3875' 12/3850-54, 1000A

20 gwph

PB 3825', 24/3810-18, 1000A

S/4 boph 14% wtr. 16 hrs.

PB 3800'

15/3789-94, S/4 $\frac{1}{2}$ boph 10%

CO 3820

S/4 boph 13% wtr.

Comp. 181 bopd 10% wtr.

COMPLETED

J. G. McGEHEE

J. G. McGEHEE


County Pawnee State Kansas

Sec. 31 (Blk. Twp.) 23 (Sur. Rge.) 15W Map No.

Operator Lion Oil

Well No. 5 Farm Gano

Elev. 2044 Location C E L S E N E

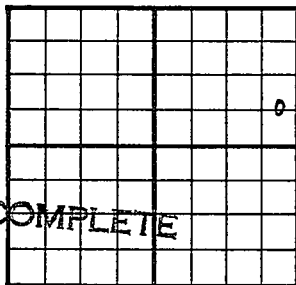

660Ft. From S Line NE

330Ft. From E Line Quarter

Ist. Report

Completion MAR 10 1954

Remarks Benson Pool

Garvey - Contr.

Spudding Date 1-27-54

Drlg. Data Oil well TD 3901

8" @ 275 Heeb. 3477 Br. lime 3604

Lans. 3612 DST 3607-34 open 1 hr.

Rec. 510' gas 90' o & gcm DST 3631-75

open 1 hr. Rec. 30' mud 990#

DST 3738-78 open 1 hr. Rec. 1090' gas

110' o & gcm 360# DST 3785-3830

open 1 hr. Rec. 180' gas 46' o & gcm

200# TD 3901 5" @ 3898 CO to 3875

12/ 3850-54 1000 A 20 gwph PB 3825

24/ 3810-18 1000 A S/ 4 boph 14% wtr.

16 hr. PB 3800 15/ 3789-94 S/ 4½ boph

10% CO 3820 S/ 4 boph 13% wtr.

Comp. 181 bopd 10% wtr.

J. G. McGEHEE