

Section 31 Township 23 Range 15WWell No. #1 GanoCompany Lion Oil

							0

NORTH

WEST


EAST

SOUTH

Pawnee KANSAS

Sec. 31 Twp. 23 R. 15 WWell No. # 4 Gano FarmLion Oil CompanyRine Drlg. ContractorBenson Pool990 Ft. from N. Line Ft. from S. Line330 Ft. from E. Line Ft. from W. Line

SE NE NE

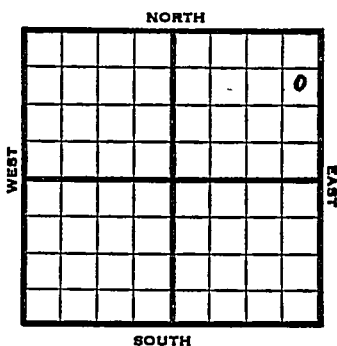

1953

2047'

REPORT

8/19

Spud 8-13-53

8" @ 308

Drlg. 3035'

8/26

Heeb 3467, Br li 3593, Lans 3603,
DST 3598-3620, 1 hr., 460' mco, 950#
20"DST 3770-92, 1 hr., 30' hlgo & gcm, &
300' mco

DST 3805-20, 20 mins., 5' m

BKC 3855

RTD 3885

5" @ 3884

9/2

CO 3884 24/ 3840-48 1000 A F 30 BO
20 Mins, F 16 BO 10 mins, 2 1/2" Trb.
F 25 BOPH 1/2" Cb.

9/9

NR

9/23

Spud 8-13-53

Oil well TD 3885' 8" @ 308

Heeb 3467 Br lime 3593

Lans 3603

DST 3498-3620 open 1 hr rec 460' MCO
950#

DST 3770-92 open 1 hr rec 30' HGO

& GCM, 300' MCO

DST 3805-20 open 1/3 hr, rec 5' mud
O#

OVER

1953

9/23

(Information continued)

B KC 3855 TD 3885 5" @ 3884

CO to 3884 24/3840-48 1000 A

F/30 BO 20 min. F/16 BO 10 min.

F/25 BOPH

Comp. 3000 BOPD

COMPLETED

County Pawnee State Kansas
 Sec. 31 (Blk. 23 (Sur. 15W Map No.
 (Twp.) (Rge.)
 Operator Lion Oil
 Well No. 4 Farm Gano
 Elev. Location SE NE NE

990 Ft. From N Line NE
330 Ft. From E Line Quarter
 1st. Report AUG 19 1953
 Completion
 Remarks
Rine Drlg. - Contr.
 Spudding Date 8-13-53

Drlg. Data Benson Pool
8" @ 308 drlg. 3035

J. G. McGEHEE

County Pawnee State Kansas

Sec. 31 (Blk. Twp.) 23 (Sur. Rge.) 15W Map No.

Operator Lion Oil

Well No. 4 Farm Gano

Elev.	2047	Location	SE NE NE
-------	------	----------	----------

0

COMPLETE

990Ft. From N Line NE

330Ft. From E Line Quarter

1st. Report

Completion SEP 23 1953

Remarks Benson Pool

Rine Drlg. - Contr.

Spudding Date 8-13-53

Drilg. Data Oil well TD 3885

8" @ 308 Heeb. 3467 Br. lime 3593

Lans. 3603 DST 3498-3620 open 1 hr.

Rec. 460' mco 950# DST 3770-92

open 1 hr. Rec. 30' hgo & gcm 300' mco

DST 3805-20 open 1/3 hr. Rec. 5' mud

0# B KC 3855 TD 3885 5" @ 3884

CO to 3884 24/ 3840-48 1000 A

F/ 30 bo 20-min. F/ 16 bo 10 min.

F/ 25 boph Comp. 3000 bopd