

DX 78-1

Pawnee KANSAS

Section 31 Township 23 Range 17 W

Well No. # 1 Wurm

Company Coppinger

NORTH

				0			

WEST

EAST

SOUTH

Pawnee KANSAS

SEC.	TWP.	R.
31	23	17W

WELL NO.

1 Wurm

FARM

COMPANY

Coppinger

CONTRACTOR

Co. Tools

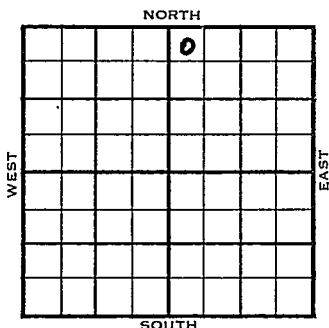
Wildcat

330 _____ Ft. from N. Line

_____ Ft. from S. Line

_____ Ft. from E. Line

330 _____ Ft. from W. Line



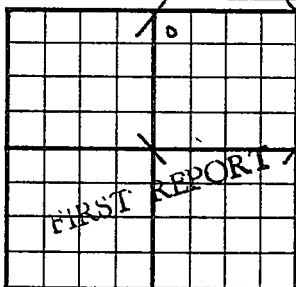
NW NW NE
Lion DHM

	ELEVATION	REPORT
1954	2114'	

10/20 MIR

12/15 Spud 10-19-54 Temp. Abd.
 TD 4740' 8" @ 234 Anhy 1130
 Heeb 3722 Br. lime 3836 KC 3844
 Miss. 4317 DST 4310-30 open 1 hr gas
 in 2½ min. 428,000 CFG rec 120' GCM
 1215# DST 4330-50 open 1 hr rec 110'
 VSGCM 1090# Misener 4368'
 DST 4365-90 open 2 hr, rec 110' mud.
 740# Viola 4403 Simp. sh. 4628'
 Arb. 4707 TD 4740 5" @ 4430
 CO to 4402 50/4336-44 S/MW 300M-A
 sd-frac. F/5½ BOPH Temp. abd.

ABANDONED

County Pawnee State KansasSec. 31 (Blk. Twp.) 23 (Sur. Rge.) 17W Map No.Operator CoppingerWell No. 1 Farm WurmElev. Location NW NW NE330 Ft. From N Line NE330 Ft. From W Line Quarter1st. Report OCT 20 1954

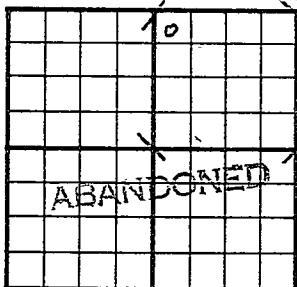
Completion

Remarks Lion - DEMCo. tools

Spudding Date

Drlg. Data WildcatM I R

FABEN GILSTRAP

County Pawnee State KansasSec. 31 (Blk.) 23 (Sur.) 17W Map No.Operator CoppingerWell No. 1 Farm WurmElev. 2114 Location NW NW NE330 Ft. From N Line NE330 Ft. From W Line Quarter

1st. Report

Completion DEC 15 1954Remarks WildcatCo. toolsSpudding Date 10-19-54Drlg. Data Temp. abd. TD 47408" @ 234 Anhy 1130 Heeb. 3722Br. lime 3836 KC 3844 Miss. 4317DST 4310-30 open 1 hr. gas in 2 $\frac{1}{2}$ min.428,000 cfg Rec. 120' gcm 1215#DST 4330-50 open 1 hr. Rec. 110' vsgcm1090# Misener 4368 DST 4365-90 open2 hr. Rec. 110' mud 740# Viola 4403Simp. sh. 4628 Arb. 4707 TD 47405" @ 4430 CO to 4402 50/ 4336-44S/ mw 300 M-A sd-frac F/ 5 $\frac{1}{2}$ bophTemp abd.

FABEN GILSTRAP