


Section 31 Township 23 Range 35W

Well No. 1 Mallons

Company Stanolind Oil and Gas Company

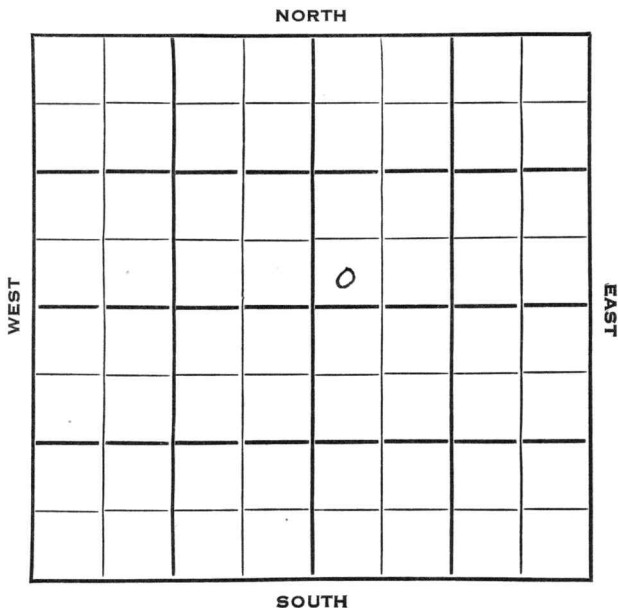

Kearney
23

KANSAS ✓

35W

31

Sec. _____ Twp. _____ R. _____

#1 Mallons

Well No. _____ Farm _____

Stanolind

Company _____

Contractor _____

Ft. from N. Line

150


Ft. from S. Line

Ft. from E. Line

150

Ft. from W. Line

SW NE

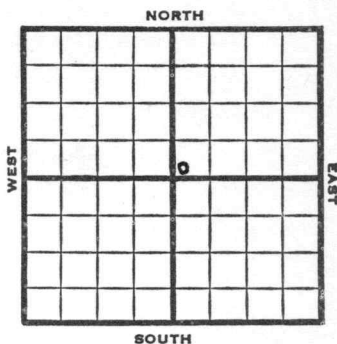

1952 Elev. 3059' REPORT

12/23 Location

12/25 Location

1/1 Location

1/8 Her 2517 Win 2575 Tow 2635 RTD 2682
5" @ 2635

1/22 NR

1/28 Spud 12-28-52 Gas well TD 2682'
 8" @ 781 Her. 2517' Win. 2575'
 Towanda 2635' TD 2682' 5" @ 2635
 CO to 2682 3000 A 18/2519-22
 60/2524-34 66/2539-50 72/2558-66
 30/2575-80 30/2585-90 24/2594-98
 12/2600-02 36/2604-10 48/2613-21
 12/2624-26 28,000 A
 Comp. 2,241,000 gas

COMPLETED

County Kearny State Kansas

Sec. 31 (Blk. Twp.) 23 (Sur. Rge.) 35W Map No.

Operator Stanolind

Well No. 1 Farm Mallons

Elev. 3059 Location SW NE

150 Ft. From S Line NE

150 Ft. From W Line Quarter

1st. Report

Completion JAN 28 1953

Remarks

Spudding Date 12-28-52

Drilg. Data Gas well TD 2682

8" @ 781 Her. 2517 Win. 2575

Towanda 2635 TD 2682 5" @ 2635

CO to 2682 3000 A 18/ 2519-22

60/ 2524-34 66/ 2539-50 72/ 2558-66

30/ 2575-80 30/ 2585-90 24/ 2594-98

12/ 2600-02 36/ 2604-10 48/ 2613-21

12/ 2624-26 28000 A

Comp. 2,241,000 gas

J. G. McGEHEE