


Section 31 Township 23 Range 36N

Well No. 1 Loucks

Company C. L. McMahan

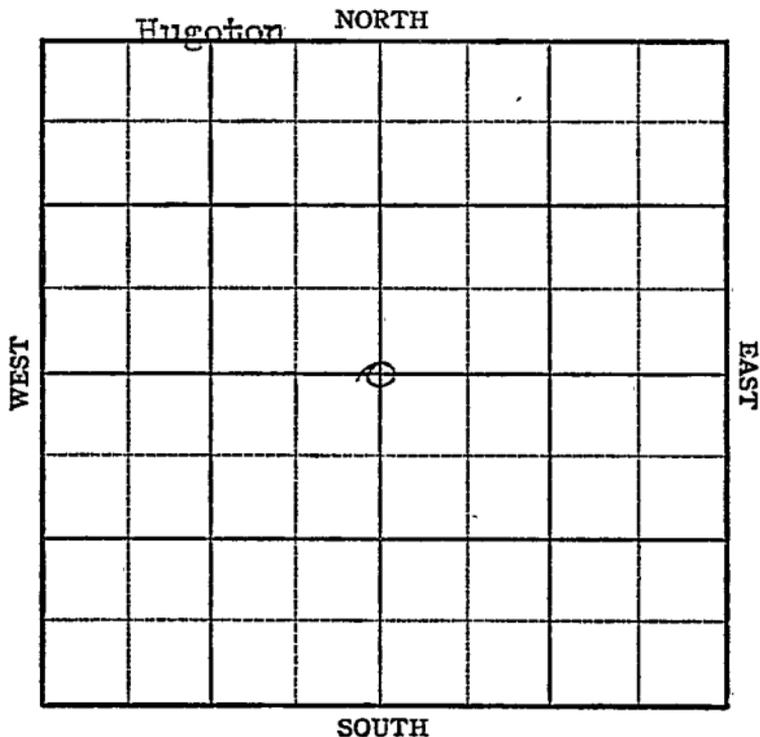

KANSAS Kearny

Sec. 31 Twp. 23 R. 36W

Well No. #1 Loucks Farm

C. L. McMahan Company

Hugoton


2640 Ft. from N. Line

\_\_\_\_\_ Ft. from S. Line

2640 Ft. from E. Line

\_\_\_\_\_ Ft. from W. Line

C Sec.

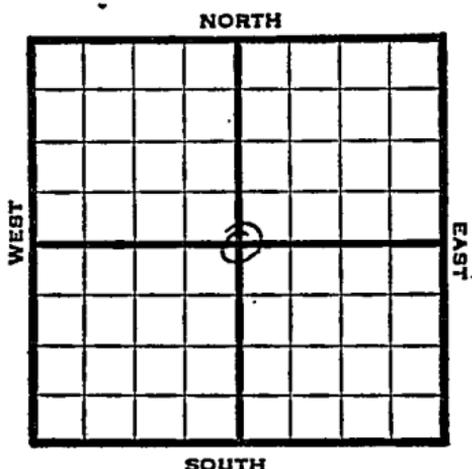

1947	Elev. 3238' REPORT
8/27	R U R
9/3	"
9/10	TD 2750' 10" @ 754' 7" @ 2728 RUST
9/17	"
9/24	Drlg. 2717'
10/1	TD 2750' 6000 Acid 84 shots 2676-90 Acid 4000
10/8	126 shots 2615-36 - 6000 acid 120 " 2567-87 - " "
10/15	"
10/22	"
10/29	"
11/5	"
11/12	"
11/19	"
11/25	"
12/3	"
12/10	"

**DVER**

1947

12/30

7" @ 2728'

Perf.

22000 acid

938,600 gas da 410# R. Pr.

TD 2750'

**COMPLETED**

Map No. \_\_\_\_\_ Sec. 31 Twp. 23 R. 36W

Well No. 1 Loucks

C. L. McMahan Company

**FIRST REPORT**

Contractor

C Sec. \_\_\_\_\_

2640 Ft. from N. Line

\_\_\_\_\_ Ft. from S. Line

2640 Ft. from E. Line

\_\_\_\_\_ Ft. from W. Line

**SECTION PLAT**


Kearny County

Location \_\_\_\_\_

Rig up \_\_\_\_\_

Drilling and Remarks:

R U R

**RECORD**

Cased \_\_\_\_\_ in., \_\_\_\_\_ ft.

Sand \_\_\_\_\_

Gas \_\_\_\_\_

Oil \_\_\_\_\_

Total Depth \_\_\_\_\_

**PRODUCTION**

1st 24 hrs. Nat. \_\_\_\_\_

1st 24 hrs. after shot \_\_\_\_\_

Gas \_\_\_\_\_ Cu. Ft.

Dry Hole \_\_\_\_\_

Abandoned \_\_\_\_\_

Date

AUG 27 1947 19

S. J. LEWIS

Scout

Map No. \_\_\_\_\_ Sec. 31 Twp. 23 R. 36W

Well No. 1 Loucks

C. L. McMahan Company

**COMPLETE**

Contractor

C Sec.

*E 13238*


**SECTION PLAT**

2640 Ft. from N. Line

\_\_\_\_\_ Ft. from S. Line

2640 Ft. from E. Line

\_\_\_\_\_ Ft. from W. Line

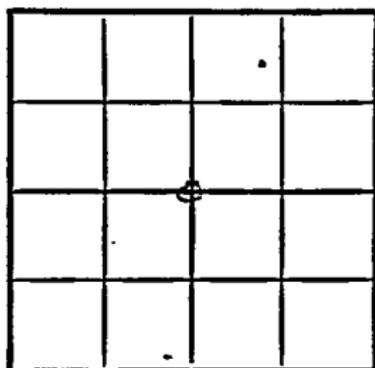

Kearny County

Location \_\_\_\_\_

Rig up \_\_\_\_\_

Drilling and Remarks:

*7° 02' 28"*

*Perf.*

*200000 cu ft*

*938,000 Gas da*

*410 # R/ft*

**RECORD**

Cased \_\_\_\_\_ in., \_\_\_\_\_ ft.

Sand \_\_\_\_\_

Gas \_\_\_\_\_

Oil \_\_\_\_\_

Total Depth 2750

**PRODUCTION**

1st 24 hrs. Nat. \_\_\_\_\_

1st 24 hrs. after shot \_\_\_\_\_

Gas \_\_\_\_\_ Cu. Ft.

Dry Hole \_\_\_\_\_

Abandoned \_\_\_\_\_

Date

DEC 30 1947 19

S. J. LEWIS

Scout