


Kearny KANSAS

Section 31 Township 23 Range 37 W
Well No. # 1 Hoehner
Company Kuhn Drlg.

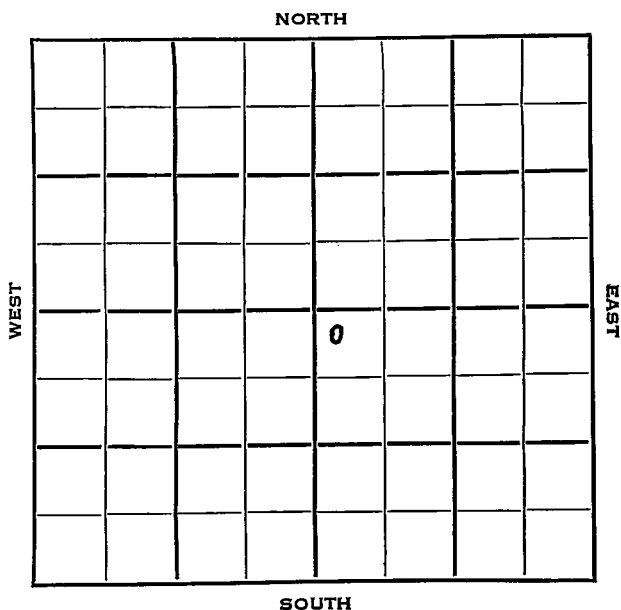

Kearney

KANSAS ✓

Sec. 31 Twp. 23 R. 37WWell No. #1 Hoehner FarmKuhn Drlg. Company

Contractor


200 Ft. from N. Line

Ft. from S. Line

Ft. from E. Line

200 Ft. from W. Line

NW SE

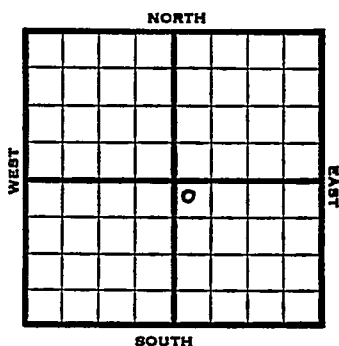

1952 Elev. 3304' REPORT

12/3 Spud 11-22-52

12/11 10" @ 320 6" @ 2574

12/18 DD 2757 TD 5000A

12/25 " " "

1/1 NR

1/8 NR

1/22 "

1/29 NR

2/5 "

2/12 "

2/19 2000A

DD 2780

236' of 5" liner

Her 2570, Win 2624, Up Ft.

2680, Low Ft. 2726, 2000A

2/26 N.R.

3/11 Spud 11-22-52 Gas well TD 2780

10" @ 320 6" @ 2574 TD 2757

5000 A DD 2780 Her 2570 Win 2624

Ft. Riley 2680 15,000 A

Comp. 6,900,000 gas

COMPLETED

County Kearny State KansasSec. 31 (Blk. Twp.) 23 (Sur. Rge.) 37W Map No.Operator Kuhn Drlg.Well No. 1 Farm HoehnerElev. Location NW SE

FIRST REPORT

200 Ft. From N Line SE200 Ft. From W Line Quarter1st. Report DEC 3 1952

Completion

Remarks

Spudding Date 11-22-52


Drlg. Data

County Kearny State Kansas
 Sec. 31 (Bk.) 23 (Sur.) 37W Map No.

Operator Kuhn Drlg.

Well No. 1 Farm Hoehner

Elev. 3304 Location NW SE

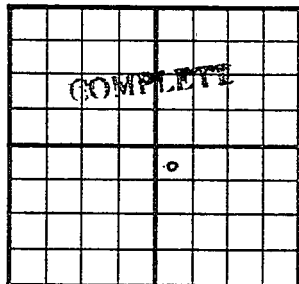

200 Ft. From N Line SE

200 Ft. From W Line Quarter

1st. Report

Completion MAR 11 1953

Remarks

Spudding Date 11-22-52

Drlg. Data Gas well TD 2780

10" @ 320 6" @ 2574 TD 2757 5000 A

DD 2780 Her. 2570 Win. 2624

Ft. Riley 2680 15000 A

Comp. 6,900,000 gas