

FORM 51 5M 4-41 PETROL


Reno

Section 32 Township 23 Range 10-W

Well No. #1 Hornbacker (Hornbaker)

Company Texas

NORTH Peace Creek Pool

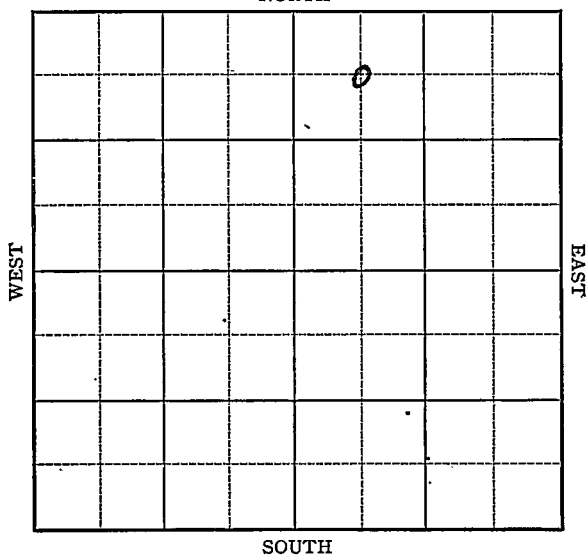

Sec. 32 Twp. 23 R. 10-W

Well No. #1 Hornbacker Farm

Texas Company


(Peace Creek)

660 Ft. from N. Line

 Ft. from S. Line

 Ft. from E. Line

660 Ft. from W. Line

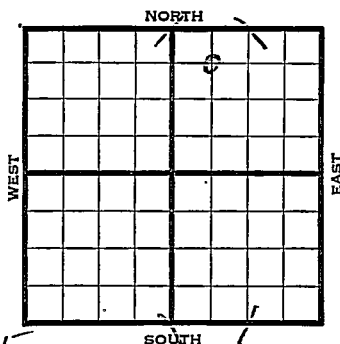

Elv. 1785

1942	REPORT
6/10	Location
6/17	10" - 168' WOC.
6/24	Drlg. 2510'
7/1	Drlg. 3427'
7/8	Lans. 3278' Viola 3620'
	Arb. 3784' T.D. 3795' Run 7".
7/15	7" - 3750' 32 shots 3634-70'
	Est. 2 M gas, no oil.
7/22	29 shots 3718-32 $\frac{1}{2}$
	10 shots 3685-91
	500 acid.
7/29	" "
8/5	" "
8/12	Viola 3620 Simp. 3718
	Arb. 3784
	T.D. 3795
	29 shots 3718-32 $\frac{1}{2}$
	10 shots 3685-91
	50 shots 3634-40 1000 acid
	416,000 cu ft gas.


COMPLETED

Map No. 47 Sec. 32 Twp. 23 R. 10WWell No. 1 HornbackerTexas CompanyFIRST REPORT Contractor

C NW NE

660 Ft. from N. Line Ft. from S. Line Ft. from E. Line660 Ft. from W. Line

SECTION PLAT

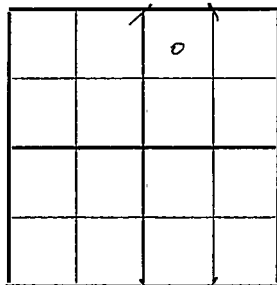

PEACE CREEK POOL

Location XXRig up Drilling and Remarks:

RECORD

Cased in., ft.Sand Gas Oil Total Depth

PRODUCTION

1st 24 hrs. Nat. 1st 24 hrs. after shot Gas Cu. Ft.Dry Hole Abandoned

Date

JUN 10 1942 19S. J. LEWIS Scout

Reno

KANSAS

Map No. 47 Sec. 32 Twp. 23 R. 10WWell No. 1 Hornbacker

Texas

Company

COMPLETED

Contractor

C NW NE

660 Ft. from N. Line

Ft. from S. Line

Ft. from E. Line

660 Ft. from W. Line

SECTION PLAT

		o	

PEACE CREEK POOL

Location

Rig up

Drilling and Remarks:

V. Sta 3620.
Sum 8718
873784
29.4 hd to 8718-82 1/2
10 " 3685-91
50 " 3634-40
1000 cuil
416,000 cu ft
Gas

RECORD

Cased _____ in., _____ ft.

Sand _____

Gas _____

Oil _____

Total Depth 3795

PRODUCTION

1st 24 hrs. Nat. _____

1st 24 hrs. after shot _____

Gas _____ Cu. Ft.

Dry Hole _____

Abandoned _____

Date

AUG 12 1942

19

S. J. LEWIS

Scout