

KANSAS


FORM 51 5M PETROL

Reno

Section 32 Township 23 Range 10-W

Well No. #2 Hornbacker (Hornbaker)

Company Texas

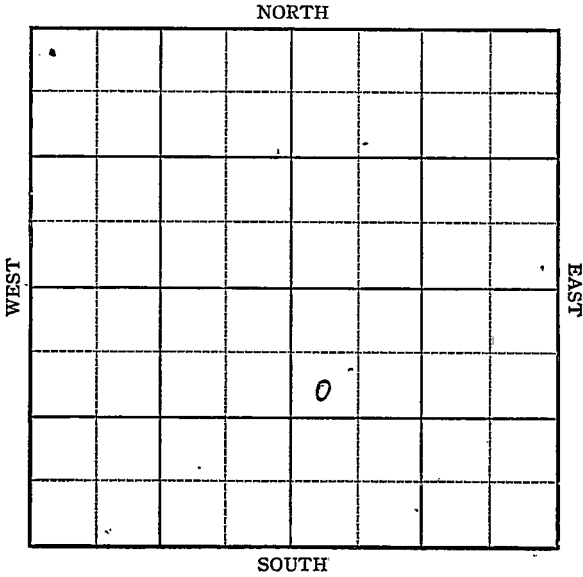

Sec. 32 Twp. 23 R. 10-W

Well No. #2 Hornbacker Farm

Texas Company


990 Ft. from N. Line

1 Ft. from S. Line

 Ft. from E. Line

330 Ft. from W. Line

Elev. 1786

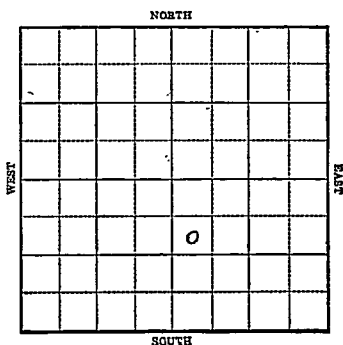

1943

R E P O R T

10/6 Derrick

10/13 Drlg. 194

10/20 Drlg. 2775

10/27 Drlg. 3550

11/3 ~~Arb~~ 3722 *Viola*

T.D. 3746

5" @ 3722

Rust.

2160' oil

11/10 T.D. 3747-2145' oil in 8 hrs

1000 acid pump 248 oil in 24 hrs

1000 acid.

11/17 ~~Arb~~ ³ 2722 *Viola*

5" @ 3722

2000 acid

Pump 133 Pot.

T.D. 3747

Gravity 42

COMPLETED

KANSAS

Map No. 47 Sec. 32 Twp. 23 R. 10W

Well No. 2 Hornbaker

Texas

Company _____

FIRST REPORT

Contractor _____

SW NW SE

SECTION PLAT

990

Ft. from N. Line

_____ Ft. from S. Line

_____ Ft. from E. Line

330

Ft. from W. Line

		o	

Pease Creek Pool

Location _____

Rig up _____

Drilling and Remarks:

Derrick

RECORD

Cased _____ in., _____ ft.

Sand _____

Gas _____

Oil _____

Total Depth _____

PRODUCTION

1st 24 hrs. Nat. _____

1st 24 hrs. after shot _____

Gas _____ Cu. Ft.

Dry Hole _____

Abandoned _____

Date

OCT 6 1943 19 _____

S. J. LEWIS Scout

KANSAS

Map No. 47 Sec. 32 Twp. 23 R. 10W

Well No. 2 Hornbacker

Texas Company

COMPLETED Contractor

SW NW SE

SECTION PLAT

990 Ft. from N. Line

_____ Ft. from S. Line

_____ Ft. from E. Line

330 Ft. from W. Line

		o	

Peace Creek Pool

Location _____

Rig up _____

Drilling and Remarks:

Cu 83722

5" C3722

2000 Acid

Pump 133 P.S.

42° N.E.

RECORD

Cased _____ in., _____ ft.

Sand _____

Gas _____

Oil _____

Total Depth 3747

PRODUCTION

1st 24 hrs. Nat. _____

1st 24 hrs. after shot _____

Gas _____ Cu. Ft.

Dry Hole _____

Abandoned _____

Date

NOV 17 1943 19

S. J. LEWIS Scout