


Reno

Section 32 Township 23 Range 10-W


Well No. #1 Masemore

Company Cities Service Oil

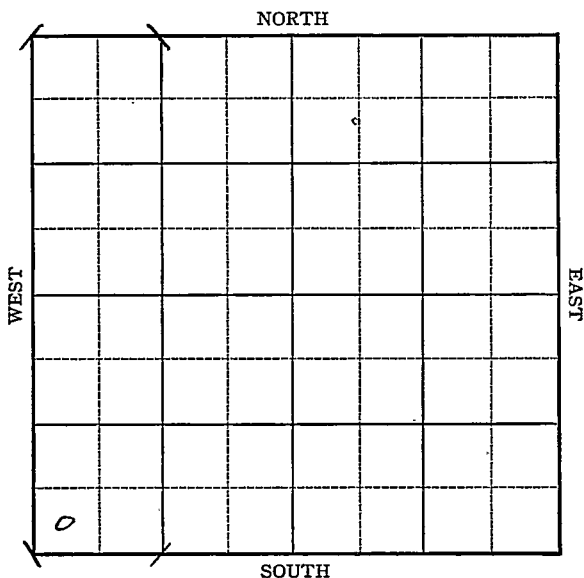

KANSASSec. 32 Twp. 23 Reno R. 10-WWell No. #1 Masemore FarmCities Service Oil Company

Zenith

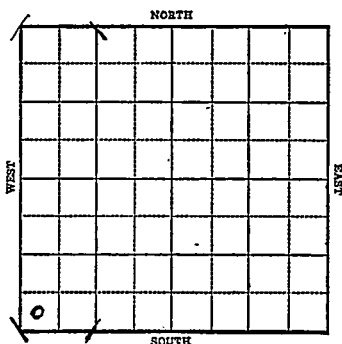 Ft. from N. Line330 Ft. from S. Line Ft. from E. Line330 Ft. from W. LineElev. 1791

1943

R E P O R T

6/23

Location

6/30

8" @ 267

7/7

Drlg. 1460'

rlg. 3606'

7/15

Lans 3274

Miss 3669

Viola 3675

T.D. 3730

5" @ 3730

Rust

7/21

46 shots 3692-3700

Est 1 M gas SSo

7/28

2½ M gas spray oil

8/4

flow 40 oil in 13 hrs.

8/11

36 shots 3705-10 frow 40 oil
in 10 hrs.

8/18

500 acle flow 168 oil in 4 hrs.

8/25

Flow 204 oil in 10 hrs thru
½" choke

9/1

" "

9/8

" "

9/15

" "

9/22

" "

OVER

1943

9/29

Viola 3675

5" @ 3730

Perferate Viola

5000 acid

Bomb Pot. 10062

Max 3000

Gravity 42

T.D. 3730'

COMPLETED

Reno

KANSAS
 Map No. 47 Sec. 32 Twp. 23 R. 10W


Well No. 1 Masemore

Cities Service Oil Company

FIRST REPORT Contractor

SW/C

SECTION PLAT

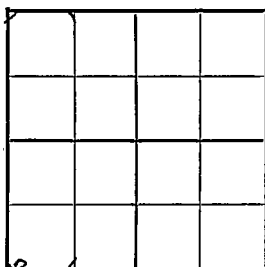

_____ Ft. from N. Line

330 Ft. from S. Line

_____ Ft. from E. Line

330 Ft. from W. Line

ZENITH POOL

Location XXX

Rig up _____

Drilling and Remarks:

RECORD

Cased _____ in., _____ ft.

Sand _____

Gas _____

Oil _____

Total Depth _____

PRODUCTION

1st 24 hrs. Nat. _____

1st 24 hrs. after shot _____

Gas _____ Cu. Ft.

Dry Hole _____

Abandoned _____

Date

JUN 23 1943

19

S. J. LEWIS


Scout

KANSAS

Map No. 47 Sec. 32 Twp. 23 R. 10WWell No. 1 MasemoreCities Service Oil CompanyCOMPLETED Contractor

SW/C

SECTION PLAT

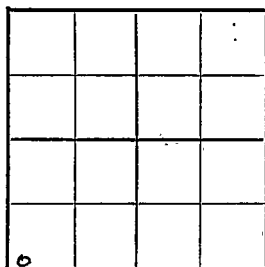 Ft. from N. Line330 Ft. from S. Line Ft. from E. Line330 Ft. from W. LineZenith PoolLocation SERig up

Drilling and Remarks:

*Viola 3675**5" @ 3730**Perforated Viola**500 acid**Boon & B 10062**Map 3000*

RECORD

Cased in., ft.Sand Gas Oil Total Depth 3780'

PRODUCTION

1st 24 hrs. Nat. 1st 24 hrs. after shot Gas Cu. Ft.Dry Hole Abandoned

Date

422 Gr

SEP 29 1943

19

S. J. LEWIS

Scout