

KANSAS


Reno

FORM 51 5M 1-42 PETROL

Section 32 Township 23 Range 10-W

Well No. 1 Souder

Company Simpson Oil

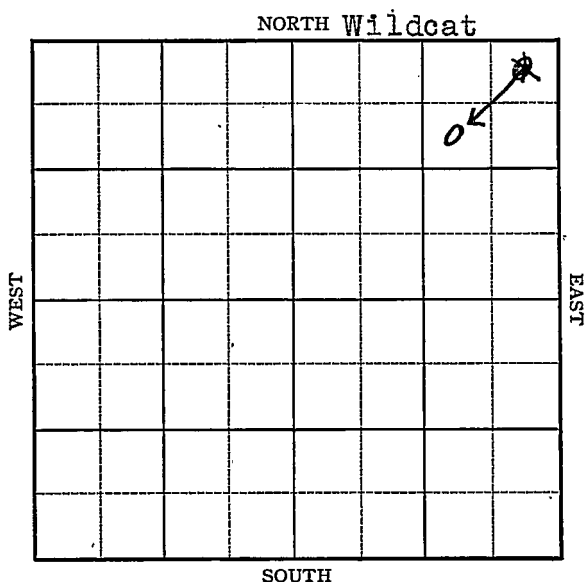

KANSAS

Reno

Sec 32 Twp. 23 R. 10-WWell No. #1 Souder "B" FarmSimpson Oil Company

(Wildcat)


330 990
Ft. from N. Line

Ft. from S. Line

990
330 Ft. from E. Line

Ft. from W. Line

Elev. 1785

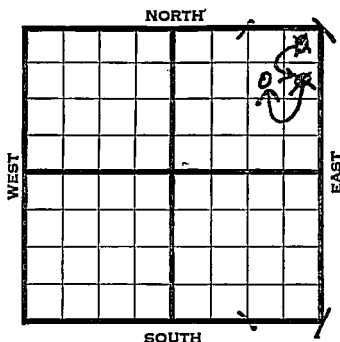

1942	REPORT
2/18	Location
2/26	8" - 190' WOC.
3/5	Anhy. 447' Ft. Riley 1710'
	Florence 1810' Wreford 1890'
	Drlg. 2110'
3/12	Topeka 2820' Lans. 3295'
	Cong. 3261' Kind. 3651' Viola 3671'
	T.D. 3731' S.O. 5" - 3675' RUST.
3/19	P.B. to 3670' 1000 acid.
3/26	" " "
4/2	Fishing.
4/8	Set whipstock.
4/15'	P.B. to 3023' Drlg. 3083'
4/22	" " "
4/29	Drlg. 3377'
5/6	" "
5/13	" "
5/20	Drilled deeper. Estimated 200 bbls.
5/27	T.D. 3740' 1500 acid. Flow 20 oil
	per hour.
	OVER

1942

6/3

Viola 3671'

5" - 3715'

T.D. 3734'

2500 acid.

Bomb potential 1106 bbls.

42. Gravity


COMPLETED

Map No. 47 Sec. 32 Twp. 23 R. 10WWell No. 1 SouderSimpson Oil Company**FIRST REPORT** Contractor

NE/C

330 Ft. from N. Line Ft. from S. Line330 Ft. from E. Line Ft. from W. Line

SECTION PLAT

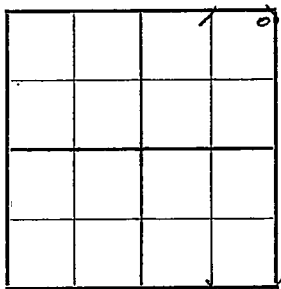

WILDCAT

Location XXXRig up

Drilling and Remarks:

RECORD

Cased in., ft.Sand Gas Oil Total Depth

PRODUCTION

1st 24 hrs. Nat. 1st 24 hrs. after shot Gas Cu. Ft.Dry Hole Abandoned

Date

FEB 1 8 1942 19S. J. LEWIS Scout

Reno

KANSAS

Map No. 47 Sec. 32 Twp. 23 R. 10WWell No. 1 Souder "B"Simpson Oil CompanyContractor

SW NE NE

SECTION PLAT

990 Ft. from N. Line Ft. from S. Line990 Ft. from E. Line Ft. from W. Line

			o

WILDCAT

Location Rig up

Drilling and Remarks:

Had foot measurements wrong and spotted wrong

RECORD

Cased in., ft.Sand Gas Oil Total Depth

PRODUCTION

1st 24 hrs. Nat. 1st 24 hrs. after shot Gas Cu. Ft.Dry Hole Abandoned

Date

MAR 4 1942 19

S. J. LEWIS Scout

Reno

KANSAS

Map No. _____ Sec. 32 Twp. 23 R. 10W

Well No. 1 Souder "B"

Simpson Oil Company

CORRECTION Contractor

SECTION PLAT

			o

SW NE NE

990 Ft. from N. Line

Ft. from S. Line

330 Ft. from E. Line

Ft. from W. Line

WILDCAT

Location _____

Rig up _____

Drilling and Remarks:

Reported as

#1 Souder and

NE/C

RECORD

Cased _____ in., _____ ft.

Sand _____

Gas _____

Oil _____

Total Depth _____

PRODUCTION

1st 24 hrs. Nat. _____

1st 24 hrs. after shot _____

Gas _____ Cu. Ft.

Dry Hole _____

Abandoned _____

Date

FEB 25 1942

19

S. J. LEWIS

Scout

Reno

KANSAS

Map No. 47 Sec. 32 Twp. 23 R. 10WWell No. 1 Souder "B"Simpson Oil

Company

COMPLETED

Contractor

SW NE NE

SECTION PLAT

990 Ft. from N. Line Ft. from S. Line990 Ft. from E. Line Ft. from W. Line

			a

WILDCAT

Location Rig up

Drilling and Remarks:

V. 186 3671
5" @ 3715
25000 cu ft
Born 8/28/106

H. 2 9/16

RECORD

Cased in., ft.Sand Gas Oil Total Depth 3734

PRODUCTION

1st 24 hrs. Nat. 1st 24 hrs. after shot Gas Cu. Ft.Dry Hole Abandoned

Date

JUN 3 1942 19S. J. LEWIS Scout