


Section 32 Township 23 Range 10W

Well No. #2 Masemore

Company Cities Service Oil
Peace Creek Pool

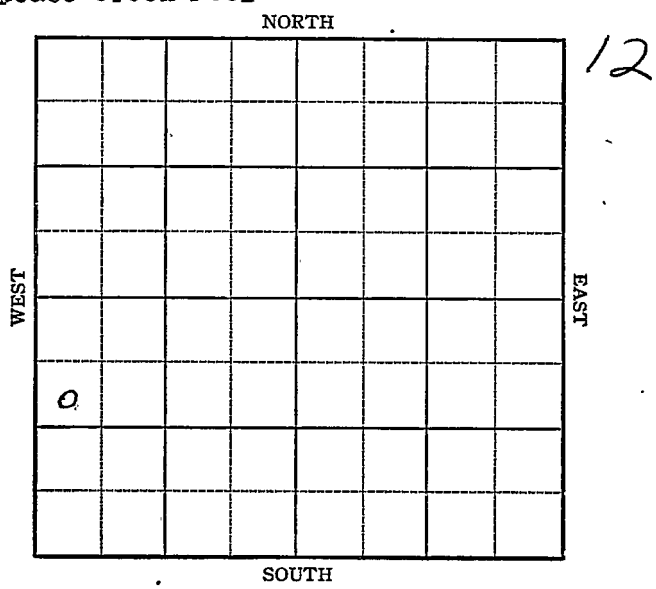

KANSAS

Reno

Sec. 32 Twp. 23 R. 10-W

Well No. #2, Masemore Farm

Cities Service Oil Company

990

Ft. from N. Line


Ft. from S. Line

Ft. from E. Line

330

Ft. from W. Line

Elev. 1792

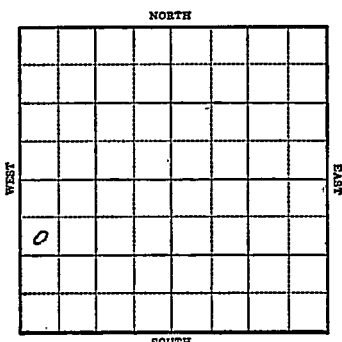

R E P O R T

1943

12/15

Rotary

12/22

8" @ 264

WOC.

12/29

Drlg 2450'

1944

1-5

Drlg 3642'

1-12

Lans 3278

Cong 3618

Viola 3662

TD 3730 5" @ 3730 RUST

1/19

5" @ 3719 Corrected

46 shots 3705-13-500 acid

Flow 276 oi in 8 hrs.

1/26

5" @ 3719

Viola 3662

TD 3730

Perf 46 shots 3705-13

Acid 500

Boml Pot. 1349

Gravity 42

COMPLETED

KANSAS

Map No. 47 Sec. 32 Twp. 23 R. 10WWell No. 2 MasemoreCities Service Oil Company
FIRST REPORT

Contractor

SW NW SW

SECTION PLAT

6			

990 Ft. from N. Line

Ft. from S. Line

Ft. from E. Line

330 Ft. from W. Line

Peace Creek Pool

Location

Rig up

Drilling and Remarks:

Rotary

RECORD

Cased in, ft.

Sand

Gas

Oil

Total Depth

PRODUCTION

1st 24 hrs. Nat.

1st 24 hrs. after shot

Gas Cu. Ft.

Dry Hole

Abandoned

Date

DEC 15 1943 19

S. J. LEWIS Scout

KANSAS
 Map No. 47 Sec. 32 Twp. 23 R. 10W

Well No. 2 Masemore

Cities Service Oil Company

COMPLETED Contractor

SW NW SW


SECTION PLAT

990 Ft. from N. Line

 Ft. from S. Line

 Ft. from E. Line

330 Ft. from W. Line

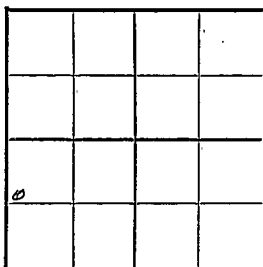

Peace Creek Pool

Location

Rig up

Drilling and Remarks:

12623662.

5" @ 3249

Perf 46 shot to 8905-10

500 acid

Bom Y B Y 1349

42 c/c

RECORD

Cased in., ft.

Sand

Gas

Oil

Total Depth 3230

PRODUCTION

1st 24 hrs. Nat.

1st 24 hrs. after shot

Gas Cu. Ft.

Dry Hole

Abandoned

Date

JAN 26 1944 19

S. J. LEWIS Scout