


Section 32 Township 23 Range 12-W

Well Number #1 Davis

Company Atlantic et al

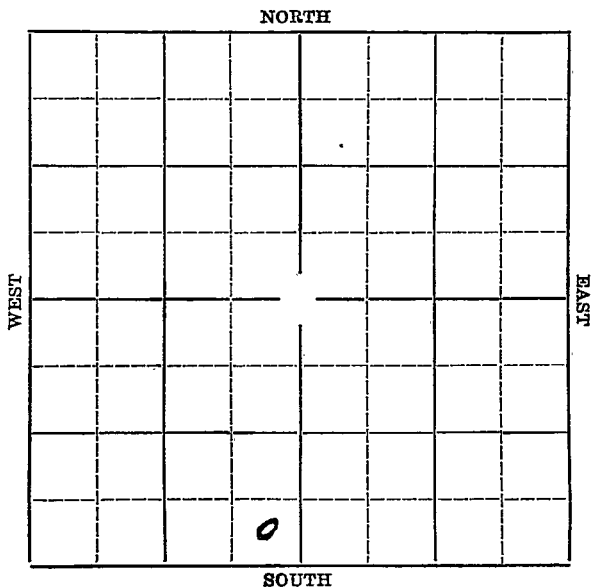


KANSAS

Stafford

Sec. 32 Twp. 23 R. 12-WWell No. 1 Davis FarmAtlantic et al Company Ft. from N. Line330 Ft. from S. Line330 Ft. from E. Line Ft. from W. Line

Elev. 1877

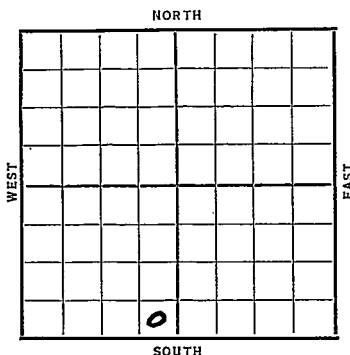Date
1936

REPORT

11/4 Rig

11/12 12" @ 245 WOC

11/19 Drlg. 1975'.

11/27 Drlg. 2535'.

12/3 Lansing 3475'. Show gas 3500-10
Drlg. 3670'.

12/9 Viola 3790

Simpson 3903

Sil. 3964 H.F.W.

TD 3985

D&A

ABANDONED

KANSAS

Map No. 46 Sec. 32 Twp. 23 R. 12WWell No. 1 DavisAtlantic & Gal Company

Contractor

SECTION PLAT

 Ft. from N. Line330 Ft. from S. Line330 Ft. from E. Line Ft. from W. Line

FIRST REPORT

Location Rig up

Drilling and Remarks:

Rig

RECORD

Cased in., ft.Sand Gas Oil Total Depth

PRODUCTION

1st 24 hrs. Nat. 1st 24 hrs. after shot Gas Cu. Ft.Dry Hole Abandoned

Date

NOV 4 1936

19

S. J. LEWIS

Scout

KANSAS

Map No. 47 Sec. 32 Twp. 23 R. 12WWell No. 1 DavisAtlantic Company

Contractor

SECTION PLAT

_____ Ft. from N. Line

330 Ft. from S. Line330 Ft. from E. Line

_____ Ft. from W. Line

ABANDONED

Location _____

Rig up _____

Drilling and Remarks:

Viola 3790.Simpson 3903Sil 3964 HFWJH7

RECORD

Cased _____ in., _____ ft.

Sand _____

Gas _____

Oil _____

Total Depth 3985

PRODUCTION

1st 24 hrs. Nat. _____

1st 24 hrs. after shot _____

Gas _____ Cu. Ft.

Dry Hole _____

Abandoned _____

Date

DEC 9 1936

19

S. J. LEWIS Scout