
FORM 51 10M 2-49 PETROL

KANSAS Stafford

Section 32 Township 23 Range 13-W

Well No. #3 Bell

Company Crown Oil
Merle Pool

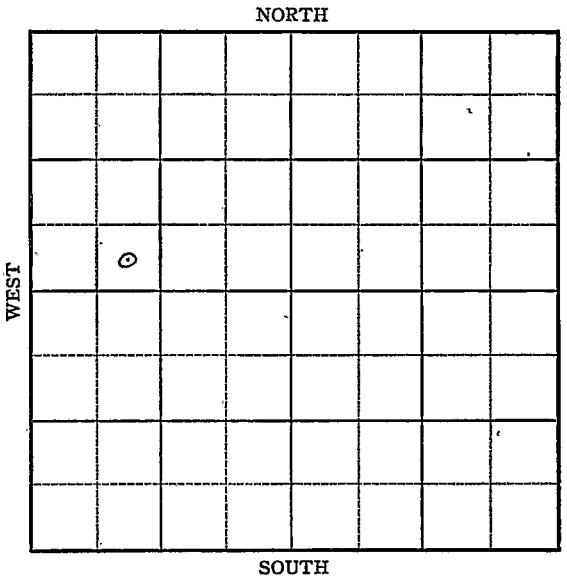

5

FORM 252-B
10M 9-49 PETROL

Stafford KANSAS

Sec. 32 - Twp. 23 R. 13W

Well No. #3 Bell Farm

Crown Oil Company

Reserve Drlg. Contractor

Merle Pool


Ft. from N. Line

330' Ft. from S. Line

Ft. from E. Line

990' Ft. from W. Line

SE SW NW

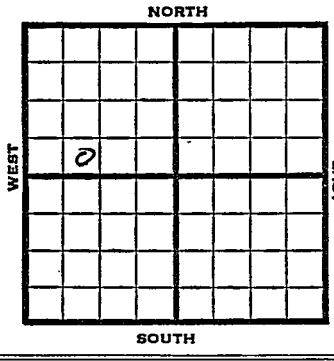

1949	REPORT
	Elev 1907'
11/9	RUR
11/16	8"@ 314'
	Drlg 2845'
11/23	Lansing 3550'
	TD 3585'
	5" @ 3578'
11/30	TD 3585'
	Lansing 3550'
	5"@ 3578'
	7000 acid
	Aband.

ABANDONED

Form 26 200 Bks. 6-49 Petrol

Kansas

Merle Pool

Map No. Sec. 32 Twp. 23 R. 13W

Well No. 3 Bell


Crown Oil Company

Reserve Drlg. Contractor

SE SW NW

FIRST REPORT

SECTION PLAT

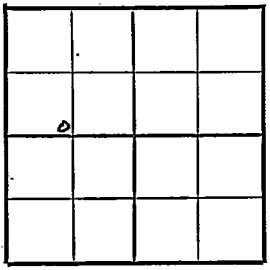

Ft. from N. Line

330 Ft. from S. Line

Ft. from E. Line

990 Ft. from W. Line

Stafford County

Location

Rig up

Drilling and Remarks:

R U R

RECORD

Cased in., ft.

Sand

Gas

Oil

Total Depth

PRODUCTION

1st 24 hrs. Nat.

1st 24 hrs. after shot

Gas Cu. Ft.

Dry Hole

Abandoned

Date

NOV 9 1949 19

S. J. LEWIS Scout

Form 26 200 Bks. 6-49 Petrol

Merle Pool

Kansas

Map No. ____ Sec. 32 Twp. 23 R. 13W

Well No. 3 Bell

Crown Oil Company


ABANDONED

Contractor

SE SW NW

E 1/1907

SECTION PLAT

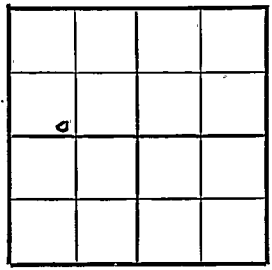

____ Ft. from N. Line

330 Ft. from S. Line

____ Ft. from E. Line

990 Ft. from W. Line

Stafford County

Location

Rig up

Drilling and Remarks:

Lane 3550
5" 3575
7000 Acid

RECORD

Cased ____ in., ____ ft.

Sand

Gas

Oil

Total Depth 3585.

PRODUCTION

1st 24 hrs. Nat.

1st 24 hrs. after shot

Gas ____ Cu. Ft.

Dry Hole

Abandoned

Date

NOV 30 1949 19

S. I. LEWIS Scout