

KANSASSection 32 Township 23 Range 13WWell No. 1 GrandyCompany Crown OilMerle
NORTH

				8			

WEST

EAST

SOUTH

KANSAS

Stafford

Sec. 32 Twp. 23 R. 13W ✓

Well No. #1 Grandy Farm

Grown Oil

Company

Merle Pool

Ft. from N. Line

990'


Ft. from S. Line

Ft. from E. Line

330'

Ft. from W. Line

NW SW NE

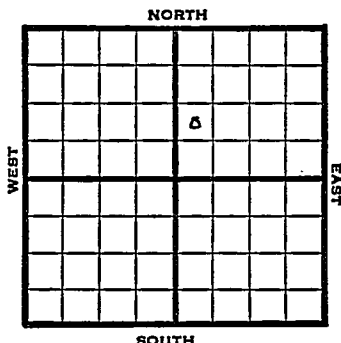

1949

Elev 1899

R E P O R T

7/13

8" @ 304'

Anhy 783'

Drlg. 1780'

7/20

Drlg 3382'

7/27

Lansing 3532'

TD 3665

5" @ 3655'

8/3

TD 3655'

Lansing 3532'

Aband.

ABANDONED

Map No. _____ Sec. 32 Twp. 23 R. 13W


Well No. 1 Grandy

Crown Oil Company

Contractor

NW SW NE

**FIRST REPORT
SECTION PLAT**

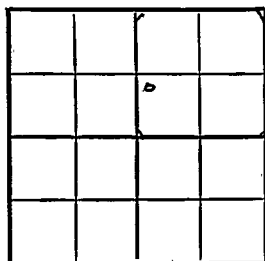

_____ Ft. from N. Line

990 _____ Ft. from S. Line

_____ Ft. from E. Line

330 _____ Ft. from W. Line

Stafford County

Location _____

Rig up _____

Drilling and Remarks:

8" @ 304

Anhy 783

drlg. 1780

RECORD

Cased _____ in., _____ ft.

Sand _____

Gas _____

Oil _____

Total Depth _____

PRODUCTION

1st 24 hrs. Nat. _____

1st 24 hrs. after shot _____

Gas _____ Cu. Ft.

Dry Hole _____

Abandoned _____

Date

JUL 1 3 1949

19

S. J. LEWIS

Scout

Kansas

Merle Pool

Map No. K83 Sec. 32 Twp. 23 R. 13WWell No. 1 Grandy

Crown Oil

Company

ABANDONED

Contractor

NW SW NE

E11898

SECTION PLAT

		4	

 Ft. from N. Line990 Ft. from S. Line Ft. from E. Line330 Ft. from W. Line

Stafford County

Location Rig up

Drilling and Remarks:

Leave 3532

RECORD

Cased in., ft.Sand Gas Oil Total Depth 3655

PRODUCTION

1st 24 hrs. Nat. 1st 24 hrs. after shot Gas Cu. Ft.Dry Hole Abandoned

Date

AUG 3 1949 19

S. J. LEWIS Scout