

# KANSAS

Stafford

Section 32 Township 23 Range 13W

Well No. 3 Williams

Company Crown Oil

**Merle**

NORTH

WEST

EAST

			δ						

SOUTH

Sec. 32 **KANSAS** Twp. 23 R. 13W ✓

Well No. #3 Williams Farm \_\_\_\_\_  
**Crown Oil** Company \_\_\_\_\_


**Merle Pool**

330' Ft. from N. Line

\_\_\_\_\_ Ft. from S. Line

330' Ft. from E. Line

\_\_\_\_\_ Ft. from W. Line

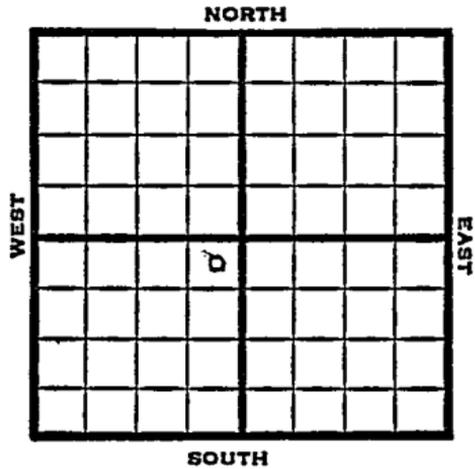

NE SW

1949	Elev 1911' REPORT
4/20	8" @ 317'
4/27	Drlg. 3320'
5/4	TD 3673' 5" @ 3665'
5/10	TD 3673- 2000 acid Flow 63 oil 1 hr.
5/18	TD 3673' Lans. 3542' 5" @ 3665' 2000 acid Depth Pot 1324' oil 25 <sup>6</sup> Gr. Comp
<b>COMPLETED</b>	

Map No. \_\_\_\_\_ Sec. 32 Twp. 23 R. 13W

Well No. 3 Williams

Crown Oil Company

**FIRST REPORT**

Contractor

NE SW

**SECTION FLAT**

330 Ft. from N. Line

\_\_\_\_\_ Ft. from S. Line

330 Ft. from E. Line

\_\_\_\_\_ Ft. from W. Line

	6		

Stafford County

Location \_\_\_\_\_

Rig up \_\_\_\_\_

Drilling and Remarks:

8" @ 317

**RECORD**

Cased \_\_\_\_\_ in., \_\_\_\_\_ ft.

Sand \_\_\_\_\_

Gas \_\_\_\_\_

Oil \_\_\_\_\_

Total Depth \_\_\_\_\_

**PRODUCTION**

1st 24 hrs. Nat. \_\_\_\_\_

1st 24 hrs. after shot \_\_\_\_\_

Gas \_\_\_\_\_ Cu. Ft.

Dry Hole \_\_\_\_\_

Abandoned \_\_\_\_\_

Date

APR 20 1949 19

S. J. LEWIS

Scout

Kansas

Merle Pool

Map No. K 83 Sec. 32 Twp. 23 R. 13W

Well No. 3 Williams

Crown Oil Company

**COMPLETE**

Contractor

NE SW

*E. 1911*  
SECTION PLAT

330 Ft. from N. Line

	0		

         Ft. from S. Line

330 Ft. from E. Line

         Ft. from W. Line

Stafford County

Location         

**RECORD**

Rig up         

Cased          in.,          ft.

Drilling and Remarks:

Sand         

Gas         

Oil         

*Line 3542*

Total Depth 2673

*5" 63665*

**PRODUCTION**

*200 acid*

1st 24 hrs. Nat.         

*Depth 1924*

1st 24 hrs. after shot         

*oil*

Gas          Cu. Ft.

Dry Hole         

*25 5/8*

Abandoned         

Date

MAY 18 1949 19

S. J. LEWIS Scout