

KANSAS

FORM 51 25M 3-49 PETRO 30

Stafford

Section 32 Township 23 Range 13W

Well No. 4 Williams

Company Crown Oil

St. Johns
NORTH

NORTH

WEST

EAST

SOUTH


KANSAS Stafford

Sec. 32 Twp. 23 R. 13WWell No. #4 Williams FarmCrown Oil Company


St. Johns (Crown Oil, Cont.) NORTH

Ft. from N. Line

990' Ft. from S. Line

990' Ft. from E. Line

Ft. from W. Line

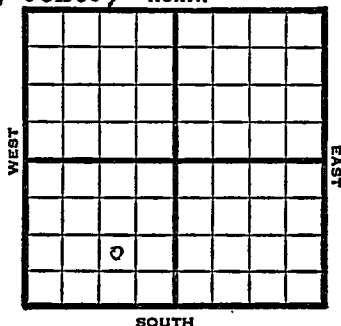

NW SE SW

1949 Elev 1913' REPORT

8/10 Location

8/17 8" @ 338'

~~8/24 Drlg. 2985'~~

8/31 Lansing 3663-68'

TD 3668'

5" @ 3665'

~~9/7 TD 3670' - 1000 acid~~
Flow 30 bbls oil PH500
No Inc.9/14 6500 acid
Flow 14 bbls oil PH

9/21 "

9/28 TD 3670'
Lans 3540'
5" @ 3665'
6500 acid
Bomb Pot 1234 Oil
39⁸ Gr.

Comp

COMPLETED

Kansas

Map No. _____ Sec. 32 Twp. 23 R. 13W

Well No. 4 Williams

Crown Oil Company

Crown Oil Contractor

NW SE SW

FIRST REPORT
SECTION PLAT

	o		

Ft. from N. Line

990 Ft. from S. Line

990 Ft. from E. Line

Ft. from W. Line

Stafford County

RECORD

Location X

Cased _____ in. _____ ft.

Rig up _____

Sand _____

Drilling and Remarks:

Gas _____

Oil _____

Total Depth _____

PRODUCTION

1st 24 hrs. Nat. _____

1st 24 hrs. after shot _____

Gas _____ Cu. Ft.

Dry Hole _____

Abandoned _____

Date

AUG 10 1949 19 S. J. LEWIS Scout

Kansas

Map No. _____ Sec. 32 Twp. 23 R. 13WWell No. 4 Williams


Crown Oil

Company

COMPLETE

Contractor

NW SE SW

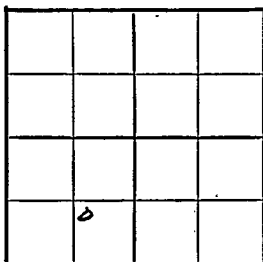F 111913
SECTION PLAT

_____ Ft. from N. Line

990 Ft. from S. Line990 Ft. from E. Line

_____ Ft. from W. Line

Stafford County

RECORD

Location _____

Cased _____ in., _____ ft.

Rig up _____

Sand _____

Drilling and Remarks:

Gas _____

Oil _____

Total Depth 2670

PRODUCTION

1st 24 hrs. Nat. _____

1st 24 hrs. after shot _____

Gas _____ Cu. Ft.

Dry Hole _____

Abandoned _____

Date

SEP 28 1949

19

S. J. LEWIS

Scout