


FORM 51 25M 3-49 PETROL

Section 32 Township 23 Range 13W

Well No. #5 Williams

Company Crown Oil

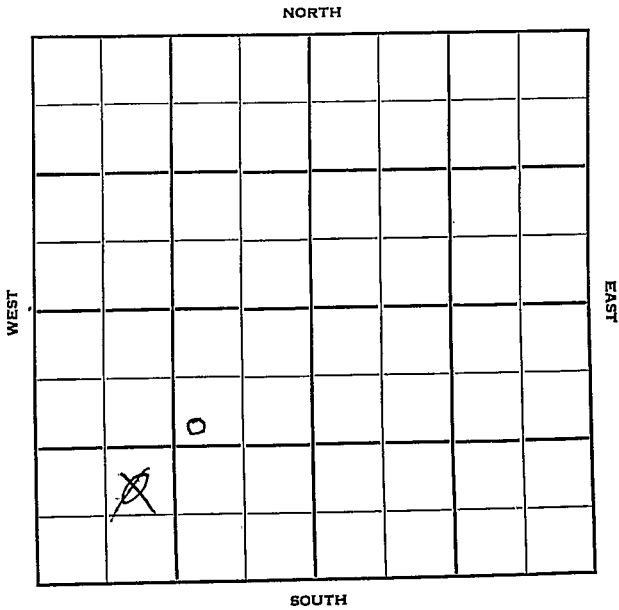

Stafford  
23

KANSAS

13W

Sec. 32 Twp. \_\_\_\_\_ R. \_\_\_\_\_


Well No. #5 Williams Farm \_\_\_\_\_

Crown Oil

Company \_\_\_\_\_

Merle Pool

NORTH

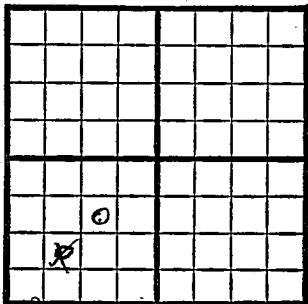

\_\_\_\_\_ Ft. from N. Line

1450

~~990~~

\_\_\_\_\_ Ft. from S. Line

\_\_\_\_\_ Ft. from E. Line

1750

~~990~~

\_\_\_\_\_ Ft. from W. Line

~~NE SW SW~~ sw ~~NE~~ sw. SOUTH

1950

Flow 1910

REPORT

1/11

Location

2/15

TD 3673'

8"@ 325'

5"@ 3667'

Heeb 3333'

Lans 3540'

1393 BOPD

Comp

**COMPLETED**

Kansas

Map No. \_\_\_\_\_ Sec. 32 Twp. 23 R. 13W

Well No. 5 Williams

Crown Oil Company

Contractor

NE SW SW

## SECTION PLAT

FIRST REPORT			
o			

\_\_\_\_\_ Ft. from N. Line

990 \_\_\_\_\_ Ft. from S. Line

\_\_\_\_\_ Ft. from E. Line

990 \_\_\_\_\_ Ft. from W. Line

Stafford County

Location X

Rig up \_\_\_\_\_

Drilling and Remarks:

## RECORD

Cased \_\_\_\_\_ in., \_\_\_\_\_ ft.

Sand \_\_\_\_\_

Gas \_\_\_\_\_

Oil \_\_\_\_\_

Total Depth \_\_\_\_\_

## PRODUCTION

1st 24-hrs. Nat. \_\_\_\_\_

1st 24 hrs. after shot \_\_\_\_\_

Gas \_\_\_\_\_ Cu. Ft.

Dry Hole \_\_\_\_\_

Abandoned \_\_\_\_\_

Date

JAN 11 1950 19

J. E. TYRA Scout

Kansas

Merle Pool

Map No. \_\_\_\_\_ Sec. 32 Twp. 23 R. 13WWell No. 5 Williams\_\_\_\_\_  
Crown Oil \_\_\_\_\_ Company\_\_\_\_\_  
CORRECTION \_\_\_\_\_ Contractor

SW NE SW

E. 1910

SECTION PLAT

\_\_\_\_\_  
Ft. from N. Line1750 Ft. from S. Line\_\_\_\_\_  
Ft. from E. Line1750 Ft. from W. Line

	o		

Stafford County

Location \_\_\_\_\_

Rig up \_\_\_\_\_

Drilling and Remarks:

Reported

NE SW SW

## RECORD

Cased \_\_\_\_\_ in., \_\_\_\_\_ ft.

Sand \_\_\_\_\_

Gas \_\_\_\_\_

Oil \_\_\_\_\_

Total Depth \_\_\_\_\_

## PRODUCTION

1st 24 hrs. Nat. \_\_\_\_\_

1st 24 hrs. after shot \_\_\_\_\_

Gas \_\_\_\_\_ Cu. Ft.

Dry Hole \_\_\_\_\_

Abandoned \_\_\_\_\_

Date

JAN 11 1950 19

J. E. TYRA

Scout

Map No. \_\_\_\_\_ Sec. 32 Twp. 23 R. 13W

Well No. 5 Williams

Crown Oil Company

Contractor \_\_\_\_\_

SW NE SW

*EI. 1910*  
SECTION PLAT

\_\_\_\_\_ Ft. from N. Line

1750 Ft. from S. Line

\_\_\_\_\_ Ft. from E. Line

1750 Ft. from W. Line

	COMPLETE		
	o		

Stafford County

Location \_\_\_\_\_

Rig up \_\_\_\_\_

Drilling and Remarks:

*8" @ 325*

*5" @ 3667*

*Keel-3333*

*Lans 3540*

*1393 BOPD*

RECORD

Cased \_\_\_\_\_ in., \_\_\_\_\_ ft.

Sand \_\_\_\_\_

Gas \_\_\_\_\_

Oil: \_\_\_\_\_

Total Depth 3673

PRODUCTION

1st 24 hrs. Nat. \_\_\_\_\_

1st 24 hrs. after shot \_\_\_\_\_

Gas \_\_\_\_\_ Cu. Ft.

Dry Hole \_\_\_\_\_

Abandoned \_\_\_\_\_

Date

FEB 15 1950

19

J. E. TYRA

Scout