

FORM 51 25M 3-49 PETROL

32

23


13W

Section _____ Township _____ Range _____

Well No. #6 Williams

Company Crown Oil

NORTH

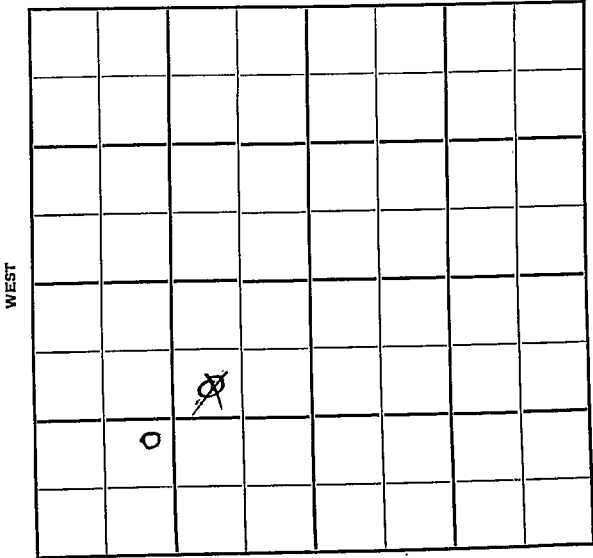

13

SOUTH

Stafford

KANSAS ✓

Sec. 32

Twp. _____

23

R. 13W

Well No. #6 Williams

Farm _____

Drown Oil

Company _____


Merle Pool

~~990~~ Ft. from N. Line

850 Ft. from S. Line

~~990~~ Ft. from E. Line

900 Ft. from W. Line

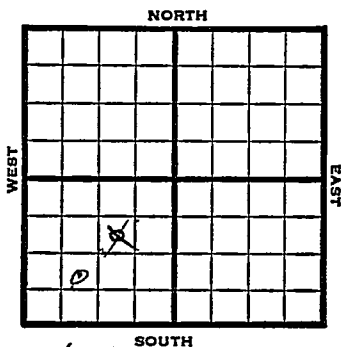

~~SW NE SW~~

NE SW SW

SOUTH

1950

Nov. 1916

REPORT

1/11

Location

3/1

8" @ 325'

5" @ 3666'

KG 3540'

1028 BOPD

TD 3675'

COMPLETED

Kansas

Merle Pool

Map No. _____ Sec. 32 Twp. 23 R. 13W

Well No. 6 Williams

Crown Oil Company

Contractor

SW NE SW

SECTION PLAT

FIRST	REPORT		
	o		

990 Ft. from N. Line

_____ Ft. from S. Line

990 Ft. from E. Line

_____ Ft. from W. Line

Stafford County

RECORD

Location X

Rig up _____

Drilling and Remarks:

Cased _____ in., _____ ft.

Sand _____

Gas _____

Oil _____

Total Depth _____

PRODUCTION

1st 24 hrs. Nat. _____

1st 24 hrs. after shot _____

Gas _____ Cu. Ft.

Dry Hole _____

Abandoned _____

Date

JAN 11 1950 19

J. E. TYRA Scout

Map No. _____ Sec. 32 Twp. 23 R. 13W

Well No. 6 Williams

Crown Oil Company

CORRECTION Contractor

NE SW SW

E. 1916 SECTION PLAT

_____ Ft. from N. Line

850 _____ Ft. from S. Line

_____ Ft. from E. Line

900 _____ Ft. from W. Line

Stafford County

Location _____

Rig up _____

Drilling and Remarks:

Reported

SW NE SW

RECORD

Cased _____ in., _____ ft.

Sand _____

Gas _____

Oil _____

Total Depth _____

PRODUCTION

1st 24 hrs. Nat. _____

1st 24 hrs. after shot _____

Gas _____ Cu. Ft.

Dry Hole _____

Abandoned _____

Date

JAN 11 1950

19

J. E. TYRA Scout

Map No. _____ Sec. 32 Twp. 23 R. 13W

Well No. 6 Williams

Crown Oil Company

Contractor

NE SW SW

El. 1916
SECTION PLAT

_____ Ft. from N. Line

850 _____ Ft. from S. Line

_____ Ft. from E. Line

900 _____ Ft. from W. Line

		COMPLETE	
o			

Stafford County

Location _____

Rig up _____

Drilling and Remarks:

8" @ 325

5" @ 3666

K.C. 3540

1028 BOPD

RECORD

Cased _____ in., _____ ft.

Sand _____

Gas _____

Oil _____

Total Depth 3675

PRODUCTION

1st 24 hrs. Nat. _____

1st 24 hrs. after shot _____

Gas _____ Cu. Ft.

Dry Hole _____

Abandoned _____

Date

MAR 1 1950

19

J. E. TYRA Scout