


Section 32 Township 23 Range 13-W

Well No. #7 Williams

Company Crown Oil

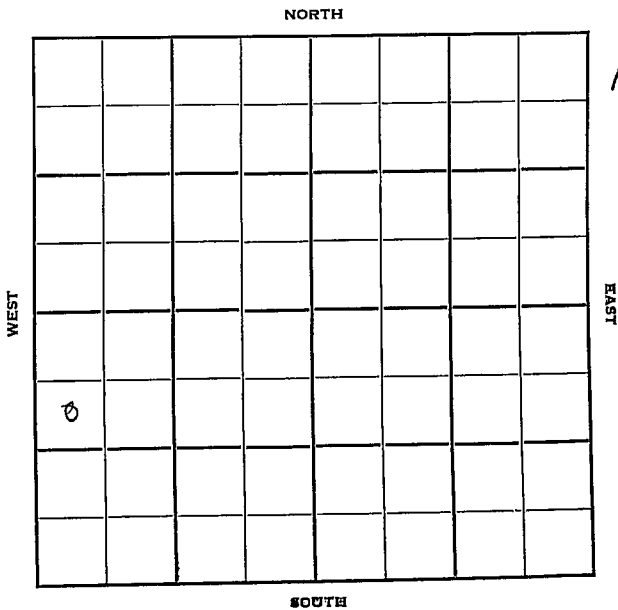

KANSAS

Stafford

Sec. 32 Twp. 23 R. 13-W

Well No. #7 Williams Farm

Crown Oil Company

Contractor

Breford Pool


990 Ft. from N. Line

\_\_\_\_\_ Ft. from S. Line

\_\_\_\_\_ Ft. from E. Line

330 Ft. from W. Line

SW NW SW

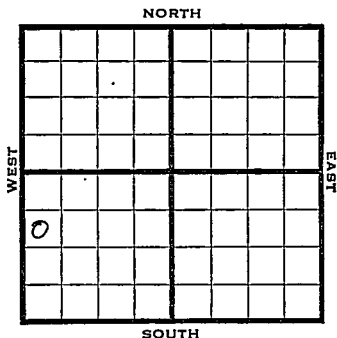

1950

Elev. 1912' REPORT

8/23

Location

9/20

Spud 8-25-50  
D&A TD 3193'  
8" @ 160'  
Anhy 770'

**ABANDONED**



