


Section 32 Township 23 Range 13-W

Well No. #7 A. Williams

Company Crown Oil

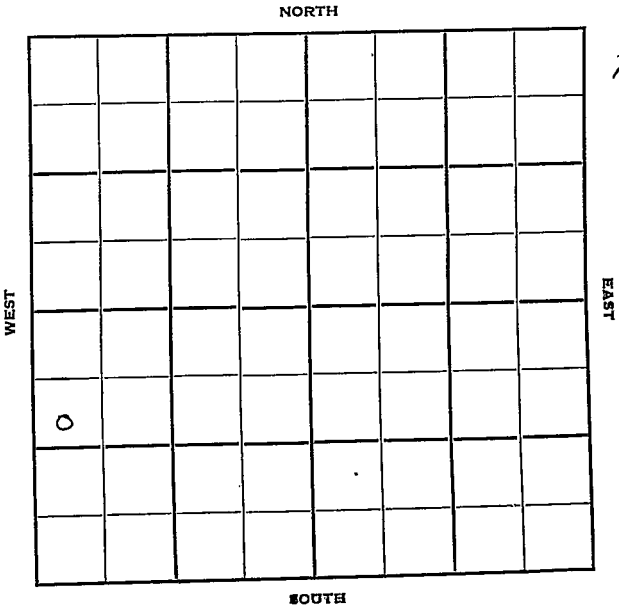

Sec. 32 Twp. 23 R. 13W ✓

Well No. #7 A. Williams Farm

Crown Oil Company

Merle Pool Contractor

1020' Ft. from N. Line


_____ Ft. from S. Line

_____ Ft. from E. Line

330' Ft. from W. Line

SW NW SW

Twin Well

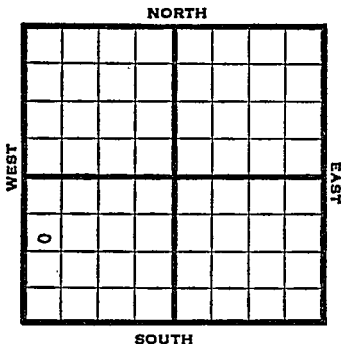

1950

Elev 1912 REPORT

9/20

Spud 9-15-50
8-5/8" @ 167'
Anhy 770-810
Drlg. 1644'

11/8

8 5/8" @ 167
Anhy 770-810 Lans 3545
5 1/2" @ 3666
TD 3679
2000 A
Comp 91 bopd 2% water
Completed

COMPLETED

