


Section 32 Township 23 Range 15W

Well No. #2 Becker (B)

Company Cities Service Oil

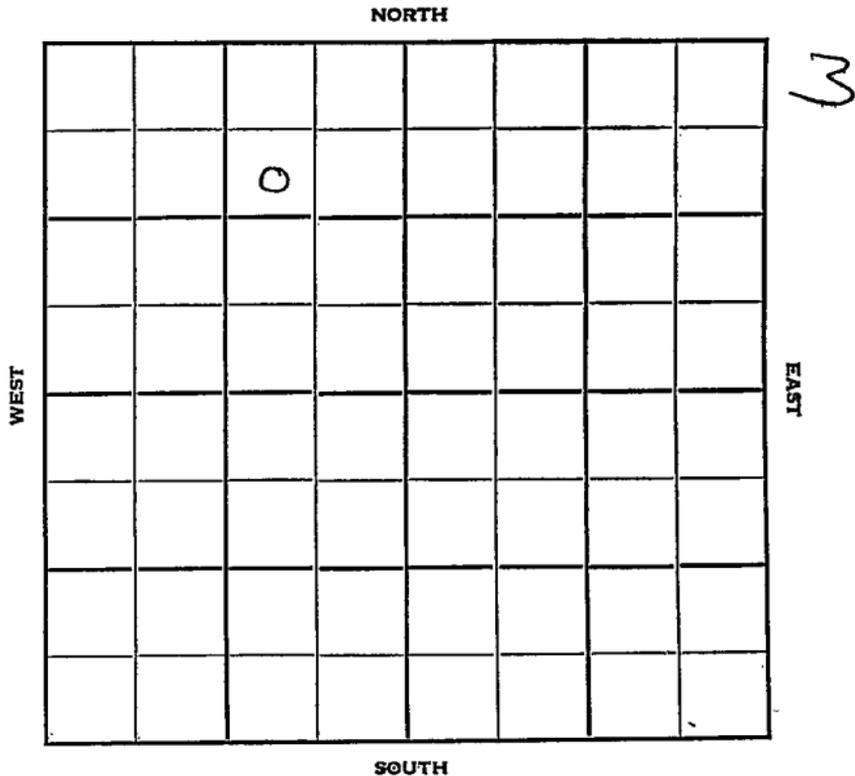

Sec. 32 Twp. 23 R. 15W

Well No. #2 Becker (B) Farm _____

Cities Service Oil Company _____

Contractor _____


990' Ft. from N. Line

_____ Ft. from S. Line

990' Ft. from E. Line

_____ Ft. from W. Line

SW NE NW

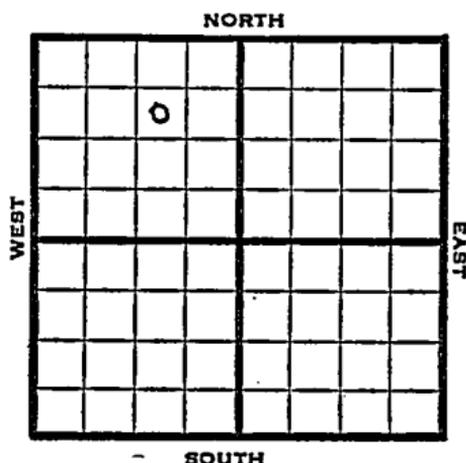

1952	Elev. 2035'	REPORT
2/27		Spud 2-24-52 8" @ 411 Drlg. 1800'
3/5		Br Li 3539 Lans. 3547 DST 3542-60 1 hr. gauge 1,790,000 gas 65' OCM 1430# DST 3563-83 1 hr. gauge 3½ M gas 68' GCM 1440#
3/12		Taking DST DST 3592-3609? DST 3620-28 1 hr 120' MG Oil 5' oil 652,000 gas 1200# DST 3670-82 1 hr. 10' muddy.oil 710' oil 180' MGOil 1250# 15" DST 3712-29 1 hr. F oil 1300 10" V. 3894 Simp 3902 TD 3938 Electric log 5" @ 3938'
3/19		NR
3/25		NR
4/1		CO to 3917' 100/3744-69 24/3777-83 3000 A F/110 BO plus 35 BW 8 hrs. Shut in for tanks.

OVER

1952

4/9 F 257 BO 6½ hrs. 5/16" ck
Set plug 3740 78/3709-29
F 160 BO & 2% BS 4 hrs 1/2" ck
F 139 BO 6 hrs. 21/64" ck.

4/23 CO to 3918 F 157 BO in 4 hrs.

4/30 NR

5/7 "

5/14 F 356 BO 1 6 hrs.

5/21 NR

5/28 "

6/11 NR

6/18 Spud 2-24-52
Oil well TD 3938' 8" @ 411
Br lime 3539' Lans. 3547'
DST 3542-60 open 1 hr, 1,790,000 gas
65' GCM
DST 3568-83 open 1 hr. 3½ MCFG
68' GCM
DST 3592-3609
DST 3620-38 open 1 hr. rec 120' MCO
5' oil, 652,000 gas.
DST 3670-82 open 1 hr. rec 10' muddy
oil, 710' oil, 180' MCO
DST 3712-29 open 1 hr.
F/oil 10 min. Viola 3894' Simp 3902'
TD 3938' 5" @ 3938 CO to 3917
100/3744-69 24/3777-83 3000 A
F/110 BO 35' BW 8 hr. F/257 BO 6½ hr.
SP 3740 78/3709-29 F/160 BO 2% bs
4 hr. F/139 BO 6 hr. CO to 3918'
F/157 BO 4 hr. F/356 BO 16 hr.
Comp. BHB 1928 BOPD

COMPLETED

County **Pawnee** State **Kansas**

Sec. **32** (Blk. Twp.) **23** (Sur. Rge.) **15W** Map No.

Operator **Cities Service Oil**

Well No. **2** Farm **Becker (B)**

Elev. Location **SW NE NW**

990 Ft. From **N** Line **NW**

990 Ft. From **E** Line Quarter

1st. Report **FEB 27 1952**

Completion

Remarks

Spudding Date **2-24-52**

Drlg. Data **Benson - SE**

8" @ 411 Drlg. 1800

J. G. McGEHEE

Drlg. Data

4 hr. F/ 139 bo 6 hr. CO to 3918

F/ 157 bo 4 hr. F/ 356 bo 16 hr.

Comp. BHB 1928 bopd

.....	Misc.
.....	Pierce Map
.....	France Map
.....	Tracings
.....	Land Wall Map
.....	Land Small Map
.....	Scout Cards

W. W.

JUN 25 1952