


Section 32 Township 23 Range 15W

Well No. #3 Becker (B)

Company Cities Service Oil

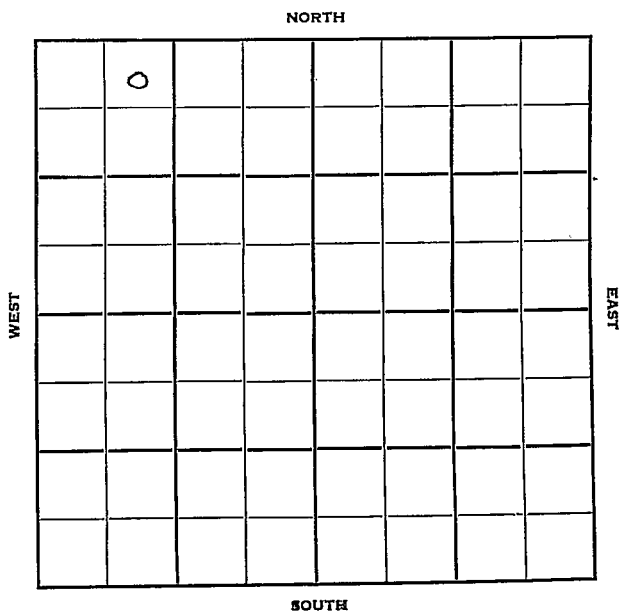

Sec. 32 Twp. 23 R. 15 W

Well No. # 3 Becker (B) Farm

Cities Service Oil Company

Contractor


330 Ft. from N. Line

Ft. from S. Line

Ft. from E. Line

990 Ft. from W. Line

NE NW NW

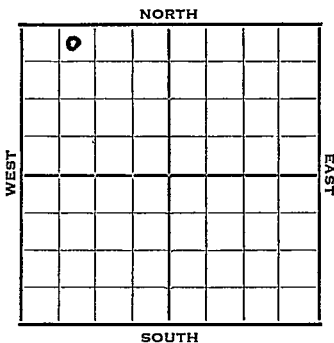

1952 Elev. 2047' REPORT

4/16 Spud 4-11-52
8" @ 250'
Drlg. 2345

4/23 Br Li 3601 Lans. 3610
DST 3604-20 1 hr. 130 GCM SSO 60'
gas cut oil 750# DST 3644-47 1 hr.
31' GCM .0# DST 3648-70 1 hr.

4/30 DST 3648-70', 1 hr, 15' M 200#
DST 3669-93, 1 hr, 60' GC & SOCM,
120' G & MCO, 1050#
DST 3788-98, 1 hr, 32' SG & OCM 200#
DST 3840-53, 1 hr, 10' M, 170' GCO
990#

V. 3956'
DST 3985-95, 1 hr, 30' salty GCM, 1330#
DST 3995-4005', 1 hr, 30' GCM 720#
Drlg. 4020'

5/7 Ero Simp 4014 Simp 4021
Simp Dol 4030 Arb. 4053
RTD 4131 5" @ 4131

5/14 43/3847-60, 770' oil 19 hrs.
41/3818-28 28/3834-41 2500 A
S/ 247 B0 24 hrs. to perf.

OVER

1952

5/21 16/ 3804-08 59/ 3785-3800 47/ 3763-75
41/ 3612-24 3000 A P/ 125 BOLLH

5/28 NR

6/11 "

6/18 NR

6/25 Spud 4-11-52
Oil Well TD 4131
8" @ 250 Br Lime 3601 Lans. 3610
DST 3604-20 opn 1 hr. Rec. 180' gcm
60' gco DST 3644-47 opn 1 hr.
Rec. 36' gcm DST 3648-70 opn 1 hr
Rec. 15' mud DST 3669-93 opn 1 hr
Rec. 28' mud DST 3766-88 opn. 1 hr.
Rec. 60' gc & socm 120' g & mco
DST 3788-98 opn 1 hr. Rec. 32' sg & ocm
DST 3840-53 opn 1 hr. Rec. 10' mud
170' gco Viola 3956
DST 3985-95 opn 1 hr. Rec. 30' salty
gcm DST 3995-4005 opn 1 hr. Rec. 30'
gcm Re-Simp 4014 Simp 4021
Simp dol 4030 Arb. 4053
TD 4131 5" @ 4131 $\frac{2087}{2006}$
43/3847-60 FU 770' oil 19 hr.
41/3818-28 28/3834-41 2500 A
S/247 bo 24 16/3804-08
59/3785-3800 47/3763-75 41/3612-24
3000 A P/125 bo 11 hr.
Comp. 437 bopd 4 bw

COMPLETED

County Pawnee State Kansas

Sec. 32 (Blk. Twp.) 23 (Sur. Rge.) 15W Map No.

Operator Cities Service Oil

Well No. 3 Farm Becker (B)

Elev. _____ Location NE NW NW

	o				

330 Ft. From N Line NW

990 Ft. From W Line Quarter

APR 16 1952

Ist. Report _____

Completion _____

Remarks _____

Spudding Date 4-11-52

Drlg. Data

8" @ 250 Drlg. 2345

County Pawnee State Kansas

Sec. 32 (Blk. Twp.) 23 (Sur. Rge.) 15W Map No.

Operator Cities Service Oil

Well No. 3 Farm Becker "B"

Elev. 2047 Location NE NW NW

0					

330 Ft. From N Line NW
990 Ft. From W Line Quarter

1st. Report

Completion JUN 25 1952

Remarks

Spudding Date 4-11-52

Drlg. Data Oil well TD 4131

8" @ 250 Br. line 3601 Lans. 3610

DST 3604-20 open 1 hr. Rec. 180' gcm

60' gco DST 3644-47 open 1 hr.

Rec. 36' gcm DST 3648-70 open 1 hr.

Rec. 15' mud DST 3669-93 open 1 hr.

Rec. 28' mud DST 3766-88 open 1 hr.

Rec. 60' gc & sccm 120' g & mco

DST 3788-98 open 1 hr. Rec. 32' sg & ocm

DST 3840-53 open 1 hr. Rec. 10' mud

170' gco Viola 3956 DST 3985-95

open 1 hr. Rec. 30' salty gcm

DST 3995-4005 open 1 hr. Rec. 30' gcm

ReSimp. 4014 Simp. 4021 Simp. dol. 4030

Drlg. Data

Arb. 4053 TD 4131 5" @ 4131

43/ 3847-60 FU 770' oil 19 hr.

41/ 3818-28 28/ 3834-41 2500 A

S/ 247 bo 24 hr. 16/ 3804-08

59/ 3785-3800 47/ 3763-75 41/ 3612-24

3000 A P/ 125 bo 11 hr.

Comp. 437 bopd 4 bw

_____	Misc.
_____	Pierce Map
_____	France Map
_____	Tracers
_____	Land Wall Map
_____	Land Small Map
_____	Scout Cards

2