

FORM 51


Pawnee

KANSAS

Section 32 Township 23 Range 15W

Well No. #3 Frick

Company Cities Service Oil Company

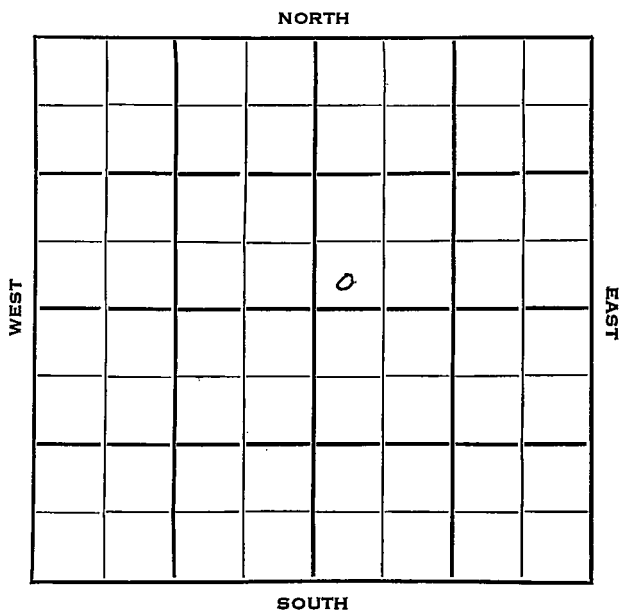

Sec. 32 Twp. 23 R. 15W

Well No. #3 Frick Farm

Cities Service Company

Barbour Contractor

SE Benson Pool


Ft. from N. Line

330 Ft. from S. Line

Ft. from E. Line

330 Ft. from W. Line

SW SW NE

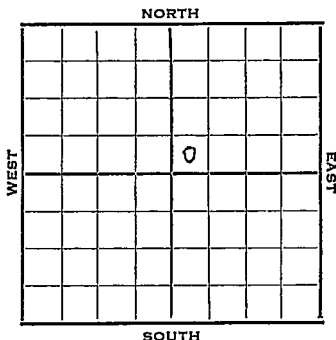

1953 Elev. 2031' REPORT

2/25 Location

3/12 Heeb 3475, Br li 3607, Lans 3617  
DST 3761-97, 1 hr., 480' gcm  
& w, 170' o & w, 70% wtr. 1020#  
Drlg. 3800

3/18 Spud 2-25-53 D & A TD 3880'  
8" @ 405 Heeb 3475 Br. line 3607'  
Lans. 3617'  
DST 3761-97, open 1 hr. rec 480' GCM  
& W. 170' oil & wtr. 70% wtr.  
1020# B KC 3862 TD 3880  
D & A

**ABANDONED**



