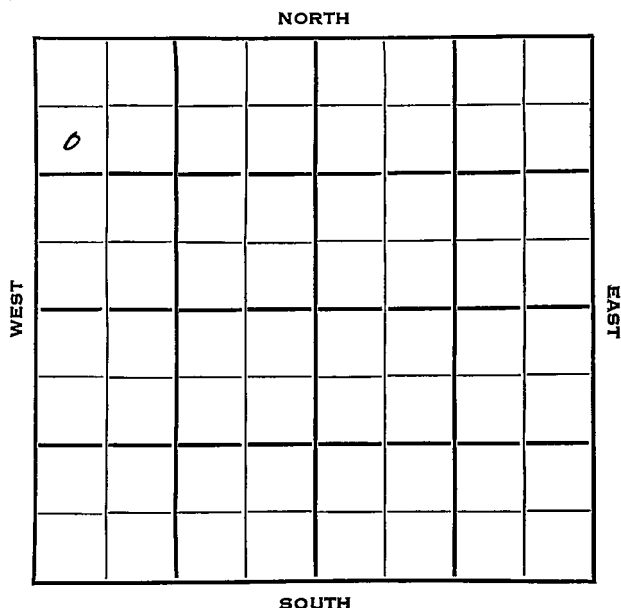


Section 32 Township 23 Range 15WWell No. #7 Becker "B"Company Cities Service Oil Company

Pawnee

KANSAS ✓

32

23

15W

Sec. _____ Twp. _____ R. _____

#7 Becker "B"

Well No. _____ Farm _____

Cities Service Oil

Company _____

Barbour

Contractor _____

990

Ft. from N. Line


Ft. from S. Line

Ft. from E. Line

330

Ft. from W. Line

SW NW NW

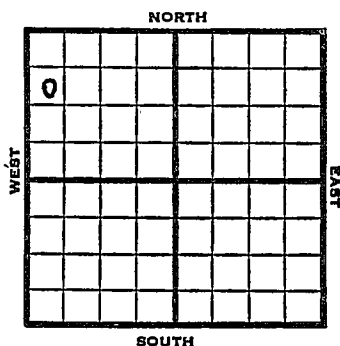

1953

Elev. 2046'

REPORT

2/4

Spud 2-1-53

8" @ 386

Dr1g. 1245'

2/12

"

2/19

Br 1i 3582, Lans 3589

DST 3589-3620, 1 hr., 90' GCM
1270#DST 3755-75 1 hr., 150' O&GCM
600#

B KC 3843

TD 3860

5" @ 3860, CO

2/26

CO 3848 49/3827-39 73/3793-3811

10/3763-78 3500A P/17 BOPH 4 Hrs.

4% wtr.

3/12

NR

3/19

NR

3/26

NR

4/1

Spud 2-1-53 Oil well TD 3860

8" @ 386 Heeb 3466 Br lime 3582

Lans. 3589'

DST 3589-3620 open 1 hr. rec 90' GCM
1270#DST 3755-75 open 1 hr. rec 150' O & GCM
600# B KC 3843' TD 3860' 5" @ 3860

OVER

1953

4/1

(Information continued)

CO to 3848 49/3827-39 73/3793-3811

60/3763-78 3500 A P/16 BOPH 4 hr.

4% wtr.

Comp. 366 BOPD 7 BW

COMPLETED

County Pawnee State KansasSec. 32 (Blk. Twp.) 23 (Sur. Rge.) 15W Map No.Operator Cities Service OilWell No. 7 Farm Becker "B"Elev. Location SW NW NW

0							

990 Ft. From N Line NW330 Ft. From W Line Quarter1st. Report FEB 4 1953

Completion

Remarks

Barbour - Contr.Spudding Date 2-1-53

Drlg. Data


8" @ 386 drlg. 1245

County Pawnee State Kansas
 Sec. 32 (Blk. 23 (Sur. 2 15W Map No.

Operator Cities Service Oil

Well No. 7 Farm Becker "B"

Elev. 2046 Location SW NW NW

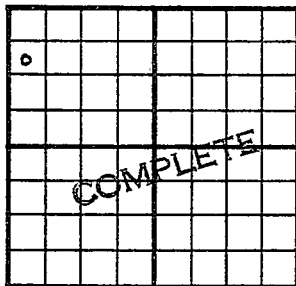

990 Ft. From N Line NW

330 Ft. From W Line Quarter

1st. Report

Completion APR 1 1953

Remarks

Barbour - Cont.

Spudding Date 2-1-53

Drig. Data Oil well TD 3860

8" @ 386 Heeb. 3466 Br. lime 3582

Lans. 3589 DST 3589-3620 open 1 hr.

Rec. 90' gcm 1270# DST 3755-75

open 1 hr. Rec. 150' o & gcm 600#

B KC 3843 TD 3860 5" @ 3860

CO to 3848 49/ 3827-39 73/ 3793-3811

60/ 3763-78 3500 A P/ 16' boph 4 hr.

4% wtr. Comp. 366 bopd 7 bw

J. G. McGEHEE