


Section 32 Township 23 Range 17WWell No. #1 AldrichCompany Sohio Pet.

NORTH

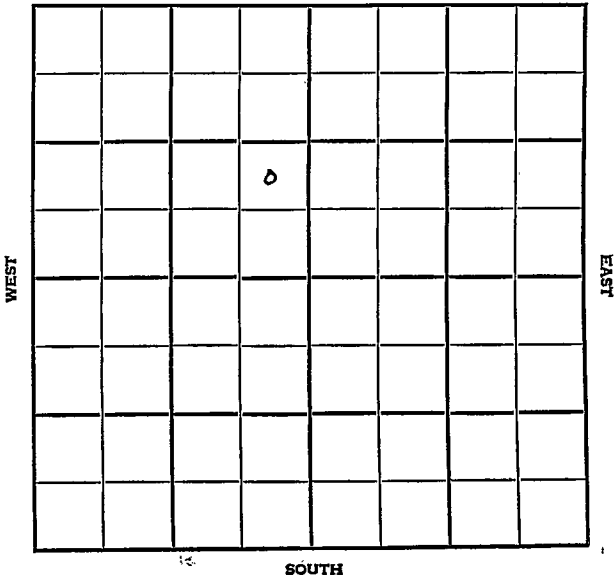

SOUTH

SEC.	TWP.	R.
32	23	17W

WELL NO.

#1 Aldrich

FARM

COMPANY

Sohio Pet.

CONTRACTOR


Wildcat.

Ft. from N. Line

990 Ft. from S. Line

330 Ft. from E. Line

Ft. from W. Line

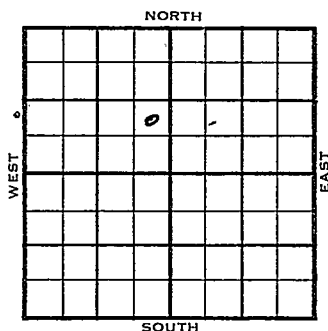

NE SE NW

	ELEVATION	REPORT
1954	2114'	
11/23	Location	
1955 1/5	Spud 11-30-54 - D&A TD 4661' Anhy 1140' 8" @ 1142' Heeb. 3714', Br. lime 3829', Lans. 3837', Miss. 4295' DST 4294-4311', opn 1 hr., gas in 33", rec. 55' sgcm, 1190# DST 4311-26', opn 1 hr., rec. 32' vsgcm, 180# DST 4326-40', opn 1 hr., rec. 20' mud, 0# DST 4276-4340', opn 2 hrs., rec. 110' gcm, 925# Misener 4345' DST 4340-71', opn 1½ hrs., rec. 90' mud, 230# Viola 4378', Simp. 4570', Arb. 4650' DST 4640-61', opn 1½ hrs., rec. 310' muddy sul. wtr., 1485# TD 4661' Schl Tops: Heeb. 3710', Br lime 3825', Lans. 3834', Cong. 4271', Miss. 4294', Kh. 4335', Misener 4346', Viola 4374'	

(Information Brought Forward)

1954

1/5

Simp. 4570', Arb. 4645'

TD 4661'

5" @ 4400'

CO to 4366'

48/4302-10'

Sd-oil-frac

F/2.92 bf 1 hrs. 35% wtr.


Went to wtr.

D&A

ABANDONED

FABEN GILSTRAP

County Pawnee State Kansas
 Sec. 32 (Blk. 23 (Sur. 17W Map No.
 (Twp.) (Rge.)
 Operator Sohio Petroleum
 Well No. 1 Farm Aldrich
 Elev. 2114 Location NE SE NW

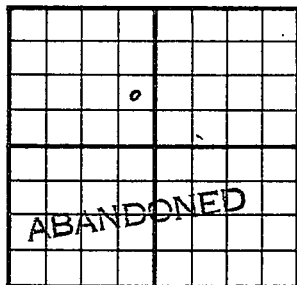

990 Ft. From S Line NW
330 Ft. From E Line Quarter
 Ist. Report
 Completion JAN 5 1955
 Remarks Wildcat

Spudding Date 11-30-54
 Drlg. Data D & A TD 4661

Anhy 1140 8" @ 1142 Heeb. 3714
Br. lime 3829 Lans. 3837 Miss. 4295
DST 4294-4311 open 1 hr. gas in 33 min.
Rec. 55' sgcm 1190# DST 4311-26
open 1 hr. Rec. 32' vsgcm 180#
DST 4326-40 open 1 hr. Rec. 20' mud
O# DST 4276-4340 open 2 hr. Rec. 110'
gcm - 925# Misener 4345 - DST 4340-71
open 1½ hr. Rec. 90' mud 230#
Viola 4378 Simp. 4570 Arb. 4650
DST 4640-61 open 1½ hr. Rec. 310' muddy
sul. wtr. 1485# TD 4661

SCHLUMBERGER TOPS: -

Heeb. 3710 Br. lime 3825 Lans. 3834

FABEN GILSTRAFF

Drlg. Data

Cong. 4271	Miss. 4294	Rh. 4335
Misener 4346	Viola 4374	Simpson 4570
Arb. 4645	TD 4661	5" @ 4400
CO to 4366	48/ 4302-10	sd oil frac
F/ 2.92 bf	1 hr. 35%	WTR IN PWT
went to wtr.		CON PWT
	D & A	

9501 17 NOV