


SECTION 32 TOWNSHIP 23 RANGE 32 W

WELL NO. #1 Jarmer Gas Unit

COMPANY Stanolind

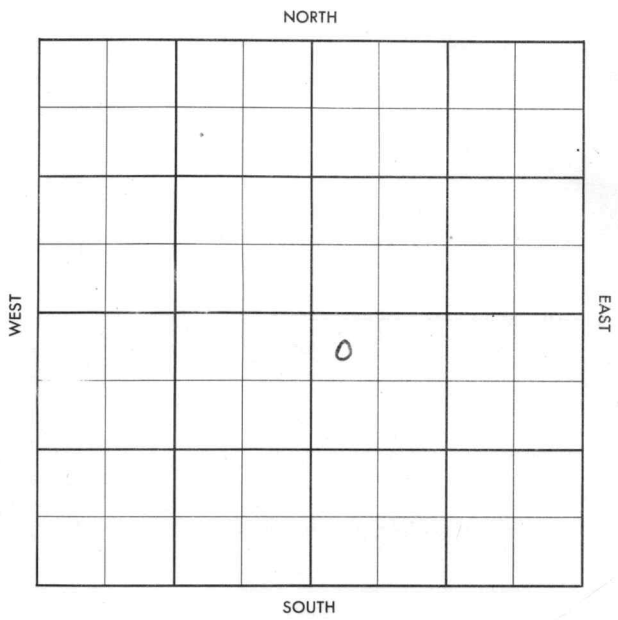


SEC.	32	TWP.	23	R.	32W
------	----	------	----	----	-----

WELL NO. #1 Jarmer FARM

COMPANY Stanolind

CONTRACTOR Noble

150' Ft. from N. Line
 _____ Ft. from S. Line
 _____ Ft. from E. Line
 150' Ft. from W. Line

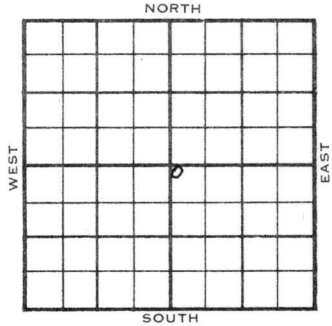

NW NW SE

1955 ELEVATION 2841' DF, 2844 REPORT 2839 GL

11-9 Loc

12-21 Comm. 11-2-55
 8 5/8" @ 975/500
 5 1/2" @ 2600/1000
 CO to 2594, 48/ 2576-84, 12/ 2588-90
 frac, 760 mcfg, 40 gwph,
 PB 2591, SP 2555
 18/ 2511-14, 72/ 2518-30, 36/ 2536-42
 60/ 2547-52, 623 mcfg, frac
 CO to 2591,
 2 mcfg, 50 gfph, 14 hrs.,
 Comp. F/ 4,970 mcfgpd, 362#
 Herr 2508
 Kri 2536
 Wfd. 2575
 TD 2604'

COMPLETED

2841 DF
2844 RB
2839 GL
32W

County Finney Elev. _____

Sec. 32 Twp. 23 Rge. _____

Company Stanplind

Farm Name Jarmer Gas Unit No. 1

TOPS	DEPTH	LOG	DATUM
Anh.			
Tp.			
H.			
Tr.			
Dg.			
Bl.			
L.			
K.C.			
B.K.C.			
Ce.			
C.			
M.			
M.			
K.			
Mz.			
Mq.			
V.			
S.			
S.			
A.			
R.			
Pf.			
G.			
T.D.			

Loc. in Sec. _____
 NW NW SE
 150' NL
 150' WL
 Geol. _____
 Contr. _____
 Noble
 Pool

FIRST REPORT
 NOV 9 '55

Date Comm. _____
 Location _____

Co.
Lse.
No.
Sec.
T.
R.

2841 DF

2844 RB

County **Finney** Elev. **2839 GF**

Sec. **32** Twp. **23** Rge. **32W**

Company **Stanolind**

FarmName **Jarmer Gas Unit** No. **1**

TOPS	DEPTH	LOG	DATUM	Loc. in Sec.				
Anh. <i>HST</i>	<i>2528</i>			NW NW SE				
Tr. <i>Kri</i>	<i>2536</i>			150' NL				
H. <i>wfd</i>	<i>2525</i>			150' WL				
Dg.				Geol.				
Bl.				Contr.				
L.				Noble				
K.C.				Pool				
B.K.C.				<table border="1"> <tr> <td colspan="2">COMPLETE</td> </tr> <tr> <td></td> <td>0</td> </tr> </table>	COMPLETE			0
COMPLETE								
	0							
Ce.								
C.								
M.								
M.								
K.								
Mz.								
Me.								
V.								
S.								
S.								
A.								
R.								
Pe.								
G.								
T.D.	<i>2604</i>							

Date Comm. **11-22-55** DEC 21 1955

8 5/8" @ 975/500 5 1/2" @ 2600/1000

CO to 2594 48/ 2576-84 12/ 2588-90

frac 760 mcfg 40 gwph PB 2591

SP 2555 18/ 2511-14 72/ 2518-30

36/ 2536-42 60/ 2547-52 623 mcfg

frac CO to 2591 2 mcfg 50 gfph

14 hr. Comp. F/ 4,970 mcfgpd 362#