


Section 32 Township 23 Range 33 W

Well No. # 1 J. H. Deines

Company Northern Pump

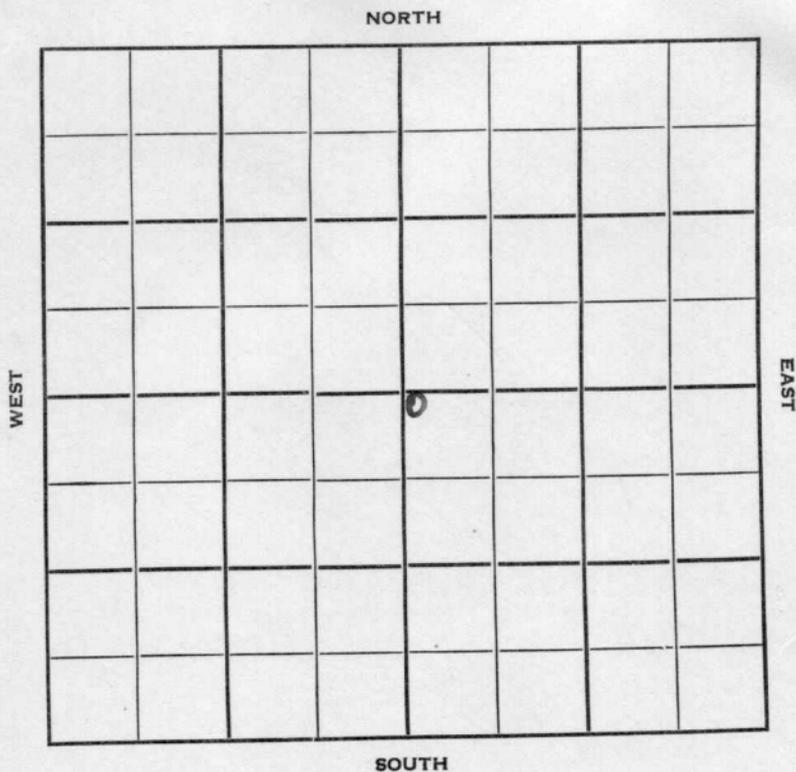

Sec. 32 Twp. 23 R. 33W

Well No. #1 J. H. Deines Farm

Northern Pump Company

Contractor


100 Ft. from N. Line

Ft. from S. Line

Ft. from E. Line

100 Ft. from W. Line

NW NW SE

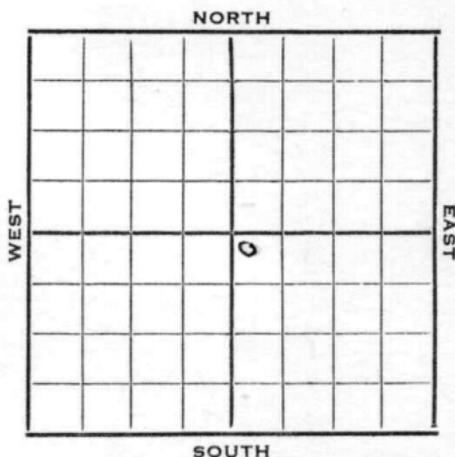

1952 Elev. 2901' REPORT

9/10 Location

9/17 10" @ 397'
Drlg. 1395'

9/24 RTD 2605 7" @ 2602
Her 2536 Winfield 2596

10/1 NR

10/8 "

10/15 "

10/22 "

10/29 "

11/5 "

11/12 "

11/20 NR

11/27 "

12/4 "

12/11 NR

12/18 NR

12/25 NR

1/1 NR

1/8 NR

1/22 DD 2621 TD

1/29 10,000 A

OVER

#1 Hoffman

1953

2/5 NR

2/12 NR

2/19 "

2/26 N.R.

3/12 NR

3/19 "

3/26 "

4/2 Dol-frac

4/8 Spud 9-12-52

Gas well TD 2621' 10" @ 397

7" @ 2602 TD 2605 Her. 2536

Win. 2596 CO to 2583 52/2537-50

24/2566-72 St-frac. 5250 A

40/2556-66 DD 2621 10,000 A

Comp. 3,146,000 gas 361#

COMPLETED

1st report shows
section 32

Comp ticket say 32

APR 20 1953

Scout Cards	mm
Land Small Map	
Land Wall Map	9
Tracings	
France Map	
Pierce Map	
Misc.	

Orig. Data