


Kearny

KANSAS

Section 32 Township 23 Range 35 W

Well No. # 1 White Gas Unit "G"

Company Stanolind Oil & Gas

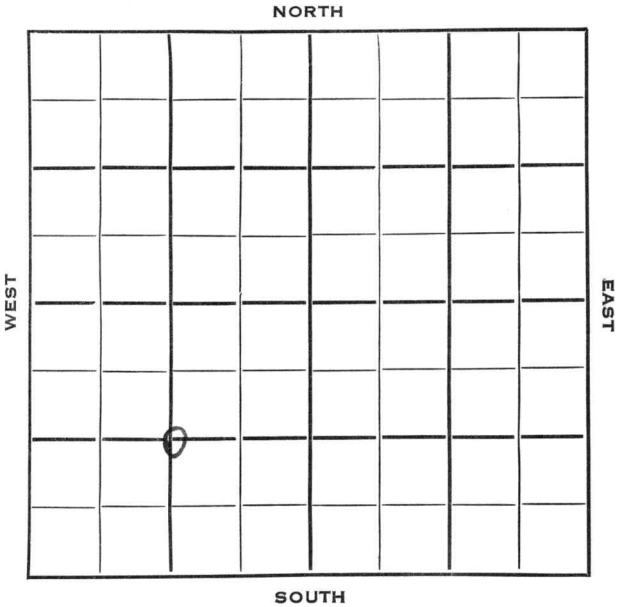

Kearny

KANSAS ✓


Sec. 32 Twp. 23 R. 35WWell No. #1 White Gas Unit "G" FarmStanolind O & G Company

Contractor

Hugoton Pool

1355 Ft. from N. Line Ft. from S. Line Ft. from E. Line1355 Ft. from W. Line

NW SE SW

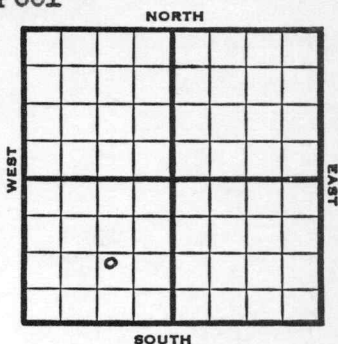


1953 Elev. 3038'

REPORT

7/22 Location
 7/29 8" @ 768
 8/5 Her 2504, Win 2565, Up. Ft. 2621
 RTD 2656
 5" @ 2625'
 8/12 CO, testing.
 8/19 N.R.
 8/26 Spud 7-23-53
 Gas Well
 TD 2656
 8" @ 768
 Her 2504, Win 2565, Ft. Riley
 2621
 TD 2656
 5" @ 2625
 CO to 2656
 A-frac - PB 2619
 30/2504-09, 66/2513-24, 96/2528-44,
 34/2565-69, 48/2572-80, 30/2583-88,
 24/2590-94, 24/2596-2600, 24/2605-09
 4500A
 4500A - CO to 2656
 Comp. 8,569,000 gas, 402#

COMPLETED

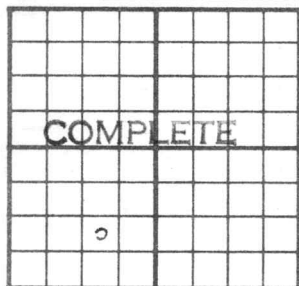County Kearny State KansasSec. 32 (Blk.
Twp.) 23 (Sur.
Rge.) 35W Map No.Operator StanolindWell No. 1 Farm White Gas Unit "G"Elev. 3038 Location NW SE SW1355Ft. From N Line SW1355Ft. From W Line Quarter

1st. Report

Completion AUG 26 1953Remarks Hugoton PoolSpudding Date 7-23-53Drilg. Data Gas well TD 26568" @ 768 Her. 2504 Win. 2565Ft. Riley 2621 TD 2656 5" @ 2625CO to 2656 A-frac PB 2619 30/ 2504-0966/ 2513-24 96/ 2528-44 34/ 2565-6948/ 2572-80 30/ 2583-88 24/ 2590-9424/ 2596-2600 24/ 2605-09 4500 A4500 A CO to 2656Comp. 8,569,000 gas 402#

J. G. McGEHEE