


Reno **KANSAS**

Section 33 Township 23 Range 7W

Well No. #1 Love

Company Atlantic

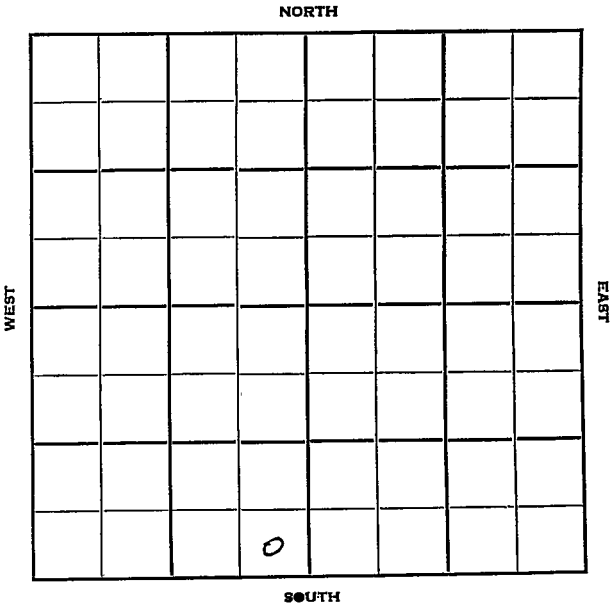

Reno KANSAS

Sec. 33 Twp. 23 R. 7W ✓

Well No. #1 Love Farm

Atlantic Company

Holm Drig. - Contr. Contractor
Wildcat


 Ft. from N. Line

330' Ft. from S. Line

330' Ft. from E. Line

 Ft. from W. Line

SE SE SW

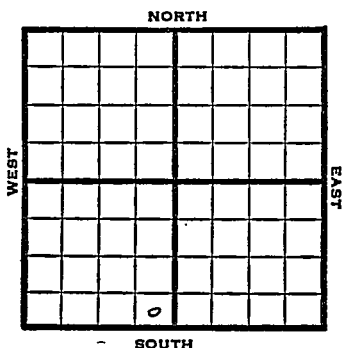

1950

Elev 1629' REPORT

11/22 MIR

12/13 Spud 11-22-50

8" @ 240

Heeb 2916

Br Lime 3016

Lans 3116

DST 3413-40 rec SW

DST 3490-3506 opn 1 hr rec 20' mud

cong 3702

Miss 3713

Misenor 4068

Viola 4072


Simp 4092

Arb 4167-4197 TD

TD 4197'

D&A

ABANDONED

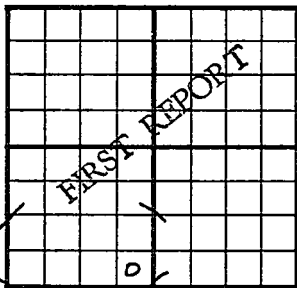County Reno State KansasSec. 33 (Blk. Twp.) 23 (Sur. Rge.) 7W Map No.Operator AtlanticWell No. 1 Farm LoveElev. Location SE SE SW330 Ft. From S Line SW330 Ft. From E Line Quarter1st. Report NOV 22 1950


Completion

Remarks Core DrillHolm Drlg. - Contr.

Spudding Date

Drlg. Data WildcatM I R

J. E. TYRA

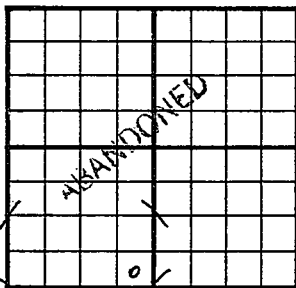County Reno State KansasSec. 33 (Blk. 23 (Sur. 7W Map No.)
(Twp.) (Rge.)Operator AtlanticWell No. 1 Farm LoveElev. 1629 Location SE SE SW330 Ft. From S Line SW330 Ft. From E Line Quarter1st. ReportCompletion DEC 13 1950Remarks WildcatHolm Drlg. - Contr.Spudding Date 11-22-50Drlg. Data D & A TD 41978" C. 240 Heeb. 2916 Br. lime 3106Lans. 3116 DST 3431-40 Rec. SWDST 3490-3506 open 1 hr. Rec. 20' mud.Conc. 3702 Miss. 3713 Misenor 4068Viola 4072 Simp. 4092 Arb. 4167-4197 TDD & A

J. E. TYRA