

KANSAS

FORM 51 5M 10-41 PETROL

Reno


Section 33 Township 23 Range 9-W

Well No. #1 McRavey

Company Nadel & Gussman

Wildcat

NORTH

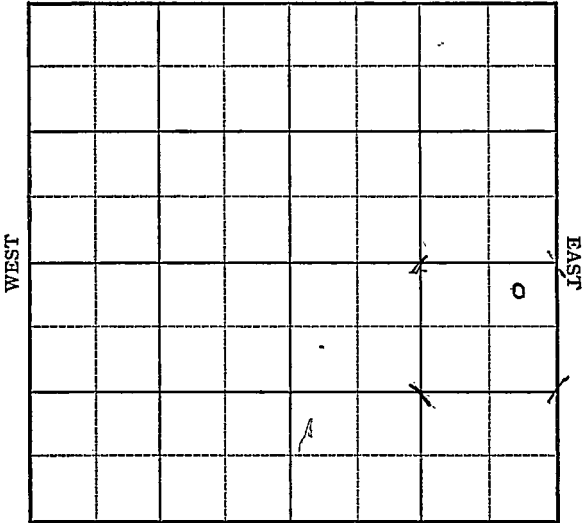

SOUTH

KANSAS

Reno

Sec. 33 Twp. 23 R. 9-WWell No. #1 McRavey FarmNadel & Gussman Company

Wildcat

330 Ft. from N. Line


Ft. from S. Line

330 Ft. from E. Line

Ft. from W. Line

NE SE

Elev. 1731

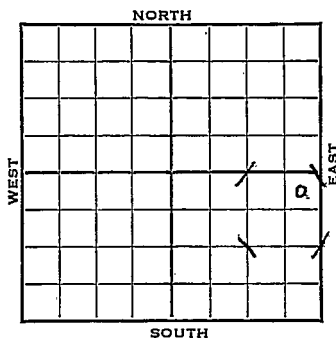

1942	REPORT
12/2	Derrick
12/9	8" @ 159 Drlg. 1550 3
12/16	Lans 8292 Drlg. 3575
12/22	Miss. 3762 SSO 3795-3810 B Miss. 3860 Viola 4060 Simpson 4125 SSO Fsg. 4158'
12/29	Arb. 4196 T.D. 4225' No shows.
	ABANDONED

KANSAS


Reno

Map No. 41 Sec. 33 Twp. 23 R. 9WWell No. 1 McRaveyNadel & Gussman Company**FIRST REPORT** Contractor

NE SE

330 Ft. from N. Line Ft. from S. Line330 Ft. from E. Line Ft. from W. Line

SECTION PLAT

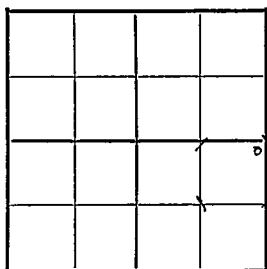

WILDCAT

Location Rig up

Drilling and Remarks:

Derrick

RECORD

Cased in., ft.Sand Gas Oil Total Depth

PRODUCTION

1st 24 hrs. Nat. 1st 24 hrs. after shot Gas Cu. Ft.Dry Hole Abandoned

Date

DEC 2 1942 19

S. J. LEWIS Scout

KANSAS

Reno

Map No. 49 Sec. 33 Twp. 23 R. 9WWell No. 1 McRaveyNadel & Gussman CompanyABANDONED Contractor

NE SE

SECTION PLAT

330 Ft. from N. Line Ft. from S. Line330 Ft. from E. Line Ft. from W. Line

			o

WILDCAT

Location Rig up

Drilling and Remarks:

*Cor 4196**No shows*

RECORD

Cased in., ft.Sand Gas Oil Total Depth 4225

PRODUCTION

1st 24 hrs. Nat. 1st 24 hrs. after shot Gas Cu. Ft.Dry Hole Abandoned

Date

DEC 29 1942 19S. J. LEWIS Scout