

KANSAS

FORM 51 5M 10-41 PETROL

Reno

Section 33 Township 23 Range 10-W

Well No. #1. Kiemel

Company Auto Ordnance


Wildcat

NORTH

WEST

EAST

SOUTH

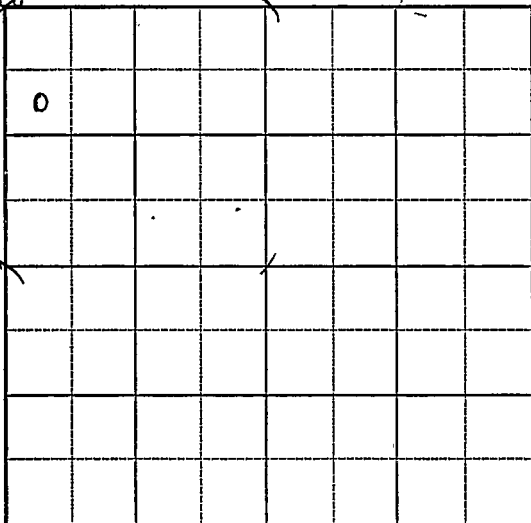

KANSAS


Reno

Sec. 33 Twp. 23 R. 10-WWell No. #1 Kiemel FarmAuto Ordnance Company

(Wildcat)

990 Ft. from N. Line Ft. from S. Line Ft. from E. Line330 Ft. from W. Line

Elev. 1782'

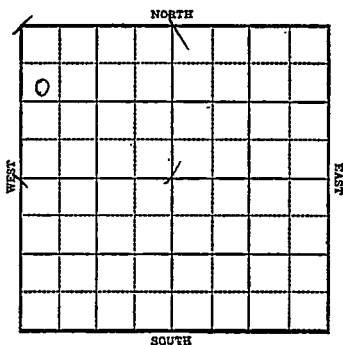

1942	R E P O R T			
10/7	Derrick			
10/14	8" @ 288 Anhy 460 Drlg. 2425'.			
10/21	Drlg 3300'			
10/28	Lans 3315 Miss 3629 B Miss 3674 Viola 3802-04 T.D TD 5"@3802 Rust			
11/4	TD 3806 500 acid Swb 17 oil per hr 1500 acid on pob			
11/11	Swab 130 Fluid 20% water.			
11/18	"	"	"	"
11/24	"	"	"	"
12/2	"	"	"	"
12/9	"	"	"	"
12/16	"	"	"	"
12/22	"	"	"	"
12/29	"	"	"	"
1943				
1/6	Viola 3802 5" - 3802 2000 acid Pump 5l oil and 30% water Pot. T.D. 3806 Gravity 42. COMPLETED			

Reno

KANSAS

Map No. 47 Sec. 33 Twp. 23 R. 10WWell No. 1 Kiemel

Auto Ordnance


Company

FIRST REPORT

Contractor

SW NW NW

SECTION PLAT

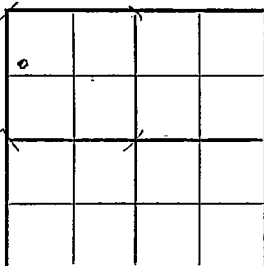990 Ft. from N. Line Ft. from S. Line Ft. from E. Line330 Ft. from W. Line

WILDCAT

Location Rig up

Drilling and Remarks:

Derrick

RECORD

Cased in., ft.Sand Gas Oil Total Depth

PRODUCTION

1st 24 hrs. Nat. 1st 24 hrs. after shot Gas Cu. Ft.Dry Hole Abandoned

Date

OCT 7 1942 19 S. J. LEWIS Scout

Reno

KANSASMap No. 487 Sec. 33 Twp. 23 R. 10WWell No. 1 Kiemel

Auto Ordnance

Company

COMPLETED

Contractor

SW NW NW

SECTION PLAT

6			

990 Ft. from N. Line Ft. from S. Line Ft. from E. Line330 Ft. from W. Line**WILDCAT**Location Rig up

Drilling and Remarks:

*Vista 3802**5" @ 3802**2000 acd**Pump 51 oil +
30% Water Pk**420 gr***RECORD**Cased in., ft.Sand Gas Oil Total Depth 3802**PRODUCTION**1st 24 hrs. Nat. 1st 24 hrs. after shot Gas Cu. Ft.Dry Hole Abandoned

Date

JAN 6 194319S. J. LEWISScout