

Well No. #1 Kremel

Company N C R A

Peace Creek Pool

0

WEST

EAST

SOUTH

KANSAS

Reno

Sec. 33 Twp. 23 R. 10W

Well No. #1 Kreme1 Farm

N C R A

Peace Creek

Company


330' Ft. from N. Line

Ft. from S. Line

Ft. from E. Line

330' Ft. from W. Line

NW/C

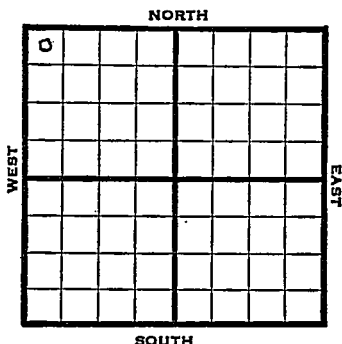

1948

Elev. 1786'

R E P O R T

6/16

8" @ 225'
Drlg. 3610'

6/23

Miss 3636
Viola 3799'
TD 3801'
4" @ 3800'

6/29

TD 3809-1200 water 100' oil

7/8

Viola 3799'
TD 3878'

ABANDONED

Map No. _____ Sec. 33 Twp. 23 R. 10W

Well No. 1 Kremel

N C R A

Company

FIRST REPORT

Contractor

NW/C


SECTION PLAT

330 Ft. from N. Line

_____ Ft. from S. Line

_____ Ft. from E. Line .

330 Ft. from W. Line

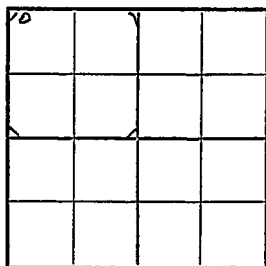

Reno County

Location _____

Rig up _____

Drilling and Remarks:

8" @ 225

drlg. 3610

RECORD

Cased _____ in., _____ ft.

Sand _____

Gas _____

Oil _____

Total Depth _____

PRODUCTION

1st 24 hrs. Nat. _____

1st 24 hrs. after shot _____

Gas _____ Cu. Ft.

Dry Hole _____

Abandoned _____

Date

JUN 16 1948

19

S. J. LEWIS

Scout

Map No. 47 Sec. 33 Twp. 23 R. 10W

Well No. 1 Kremel

N C R A

Company

ABANDONED

Contractor

NW/C

E 11786
SECTION PLAT

330 Ft. from N. Line

Ft. from S. Line

Ft. from E. Line

330 Ft. from W. Line

6			

Reno County

Location

Rig up

Drilling and Remarks:

12/10/89

RECORD

Cased 7 in., ft.

Sand

Gas

Oil

Total Depth 3878

PRODUCTION

1st 24 hrs. Nat.

1st 24 hrs. after shot

Gas Cu. Ft.

Dry Hole

Abandoned

Date

JUL 8 1948 19

S. J. LEWIS

Scout