

# KANSAS

FORM 51 5M 4-41 PETROL

Stafford

Section 33 Township 23 Range 11-W

Well No. 1 Hildebrand "A"

Company Shess & Atlantic

|  |   |  |  |  |  |  |  |
|--|---|--|--|--|--|--|--|
|  |   |  |  |  |  |  |  |
|  | 0 |  |  |  |  |  |  |
|  |   |  |  |  |  |  |  |
|  |   |  |  |  |  |  |  |
NORTH

WEST

EAST

SOUTH

Sec. 33 Twp. 23 R. 11-WWell No. #1 Hildebrand "A" FarmShell & Atlantic Company

(Semi-Wildcat)


330 Ft. from N. Line

Ft. from S. Line

Ft. from E. Line

990 Ft. from W. Line

Elev. 1815

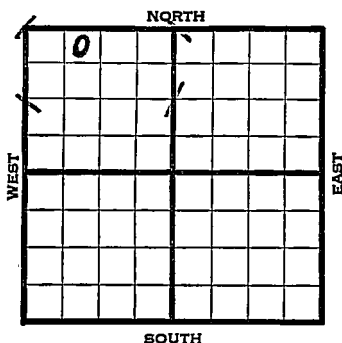

1941

REPORT

7/9 8" - 280'

Drlg. 1675'

7/17 Topeka 2850' Lans. 3319'

Drlg. 4458'

7/24 Viola 3640 Simp 3689 Arb 3757

4" @ 3757 TD 3762 RUST

7/31 TD 3694' 96 shots 3640-88 1000  
acid PB 3600- 24 shots 3449-56 1

12 shots 3468-71 12 shots 3475-

81 2000 acid SD s' ts

8/6 Arb 3757'

4" @ 3757'

TD 3694'

Water

ABANDONED


Map No. 47 Sec. 33 Twp. 23 R. 11WWell No. 1 Hildebrand "A"Shell & Atlantic CompanyFIRST REPORT Contractor

NE NW NW

330 Ft. from N. Line       Ft. from S. Line       Ft. from E. Line990 Ft. from W. Line

SEMI\*WILDCAT

## SECTION PLAT

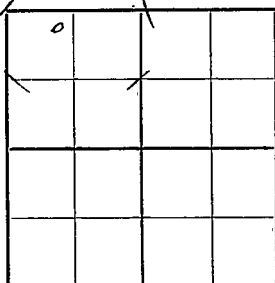Location                                 Rig up                                 

Drilling and Remarks:

8" - 280

Drlg., 1675

## RECORD

Cased            in.,            ft.Sand                                 Gas                                 Oil                                 Total Depth                                 

## PRODUCTION

1st 24 hrs. Nat.                                 1st 24 hrs. after shot                                 Gas                                  Cu. Ft.Dry Hole                                 Abandoned                                 

Date

JUL 9 1941S. J. LEWIS Scout

Map No. 47 Sec. 33 Twp. 23 R. 11WWell No. 1 Hildebrand "A"Shell & Atlantic Company

Contractor

ABANDONED

NE NW NW

330 Ft. from N. Line

Ft. from S. Line

Ft. from E. Line

990 Ft. from W. Line

SEMI\*WILDCAT

## SECTION PLAT

|   |  |  |  |
|---|--|--|--|
| △ |  |  |  |
|   |  |  |  |
|   |  |  |  |
|   |  |  |  |

Location

Rig up

Drilling and Remarks:

*Oil 3757**4103757**Water*

## RECORD

Cased \_\_\_\_\_ in., \_\_\_\_\_ ft.

Sand \_\_\_\_\_

Gas \_\_\_\_\_

Oil \_\_\_\_\_

Total Depth 3694

## PRODUCTION

1st 24 hrs. Nat. \_\_\_\_\_

1st 24 hrs. after shot \_\_\_\_\_

Gas \_\_\_\_\_ Cu. Ft.

Dry Hole \_\_\_\_\_

Abandoned \_\_\_\_\_

Date

AUG 6 1941 19S. J. LEWIS Scout