

Stafford


KANSAS

SECTION 33 TOWNSHIP 23 RANGE 11 W

WELL NO. #1 Stalcup

COMPANY Wichita River Oil Corp. & J.G. Beard

NORTH

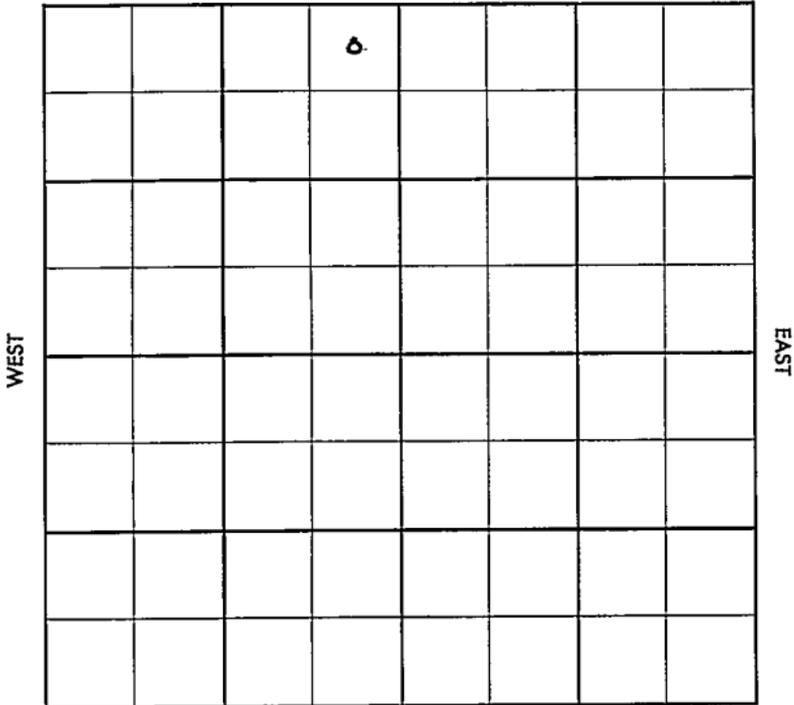

SOUTH

Stafford

KANSAS

SEC.	TWP.	R.
33	23	11W

WELL NO.

#1 Stalcup

FARM

COMPANY

Wichita River Oil Corp &amp; J. G. Beard

CONTRACTOR

Peel

Semi Wildcat

\_\_\_\_\_ Ft. from N. Line

\_\_\_\_\_ Ft. from S. Line

\_\_\_\_\_ Ft. from E. Line

\_\_\_\_\_ Ft. from W. Line

NE NE NW

			NORTH		
		0			
			SOUTH		

1955	ELEVATION	REPORT
	1809'	


10/19 TD 3784  
D & A

10/26 Comm 10-22-55  
8 5/8" @ 162'

Anh	534
Ft. Riley	1043
Top	2820
L	3309
V	3606
S	3687
A	3751

TD 3784  
DST 3326-46 open 1/2 hr Rec 8' mud  
70/20" DST 3432-68 tstd all SW  
DST 3553-63 open 1 hr Rec 15'  
so & GCM 15' msW 950/20"  
X D & A

ABANDONED

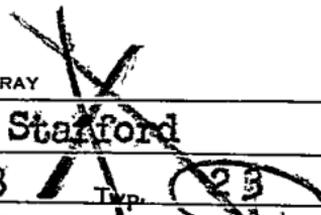

County Stafford Elev. 1809  
 Sec. 33 Twp. 23 Rge. 11W  
 Company Wichita River Oil Corp. & J.G. Beard  
 Farm Name Stalcup No. 1

TOPS	DEPTH	LOG	DATUM
Anh.			
Tr.			
H.			
Tr.			
Dg.			
Bl.			
L.			
K.C.			
B.K.C.			
Ce.			
C.			
M.			
M.			
K.			
Mz.			
Me.			
V.			
S.			
S.			
A.			
R.			
Pe.			
G.			
T.D.			

Loc. in Sec. NE NE NW  
 Geol. \_\_\_\_\_  
 Contr. Peel  
 Pool Semi Wildcat

0  
 FIRST REPORT  
 OCT 19 1955

Date Comm. TD 3784 D & A COMPLETE  
 (Hold) for Tops

Co.  
 Use.  
 No.  
 Seq.  
 T.  
 R.

County Stafford Elev. 1809  
 Sec. 33 Twp. (23) Rge. 11W  
 Company Wichita River Oil Corp. & J.G. Beard  
 FarmName Stalcup No. 1

TOPS	DEPTH	LOG	DATUM
Anb.		534	
Tp. <u>Stalcup</u>		1043	
H. <u>Top</u>		2830	1021
Tr.			
Dg.			
Bl.			
L.		3309	1500
K.C.			
B.K.C.			
Ce.			
C.			
M.			
M.			
K.			
Mz.			
Mq.			
V.		3606	1797
S.		3687	1878
S.			
A.		3751	1942
R.			
Pe.			
G.			
T.D.	3784		

Loc. in Sec. NE, NE, NW  
 Geol. \_\_\_\_\_  
 Contr. \_\_\_\_\_  
 Pool Peel  
 Semi Wildcat



Date Comm. 10-22-55 OCT 26 1955  
8 5/8" @ .163 DST 3326-46 open 1/2 hr.  
Rec. 8' mud 70/20" DST 3432-68  
tstd all SW DST 3553-63 open 1 hr.  
Rec. 15' so & gcm 15' msw 950/20"  
D & A

Co.  
 L. Sec.  
 No.  
 Sec.  
 T.  
 R.