

Section 33 Township 23 Range 12WWell No. #1 JamisonCompany Francis Raymond

NORTH

							0

WEST

EAST

SOUTH

Stafford

Sec. 33 Twp. 23 R. 12W ✓

Well No. #1 Jamison Farm

Francis Raymond Company

Contractor


330' Ft. from N. Line

Ft. from S. Line

330' Ft. from E. Line

Ft. from W. Line

NE NE NE

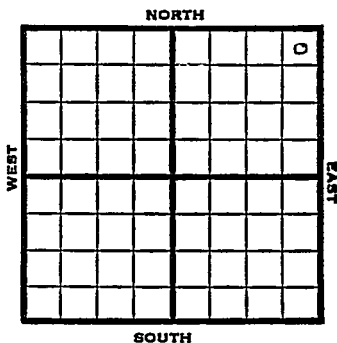

1950 Elev. 1864 REPORT

12/20 Cellar & Pits

1951

1/10 Spud 12-22-50
D&A TD 3880
8" @ 196 Arb. 3866
TD 3880 D&A

ABANDONED

3866
1864

2002

County Stafford State KansasSec. 33 (Blk. Twp.) 23 (Sur. Rge.) 12W Map No.Operator Francis RaymondWell No. 1 Farm JamisonElev. Location NE NE NE

330 Ft. From N Line NE330 Ft. From E Line Quarter1st. Report DEC 20 1950

Completion


Remarks

Spudding Date

Drlg. Data

Cellar & pits

J. E. TYRA

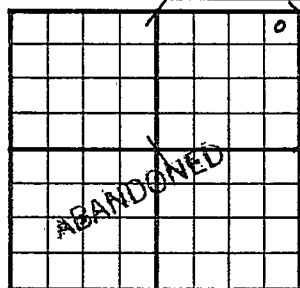County Stafford State KansasSec. 33 (Blk. 23 (Sur. 12W Map No.)
(Twp.) (Rge.)Operator Francis RaymondWell No. 1 Farm JamisonElev. 1864 Location NE NE NE330 Ft. From N Line NE330 Ft. From E Line Quarter1st. Report Completion JAN 10 1951Remarks Bedford PoolSpudding Date 12-22-50Drlg. Data D & A TD 38808" @ 196 Arb. 3866 TD 3880D & A.

J. E. TYRA