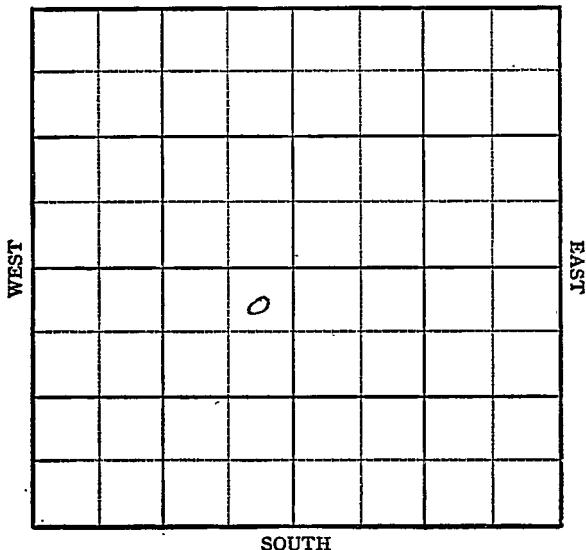


KANSAS

Stafford

Section 33 Township 23 Range 12WWell No. 1 HeyenCompany Crown OilWildcat
NORTH

KANSAS

Stafford

Sec. 33 Twp. 23 R. 12W

Well No. #1 Heyen Farm

Crown Oil Company

Wildcat


330' Ft. from N. Line

Ft. from S. Line

330' Ft. from E. Line

Ft. from W. Line

NE SW

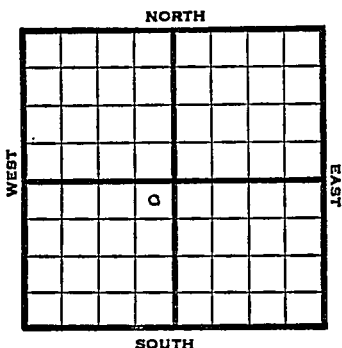

1948

Eli 1871' REPORT

10/20 RUR

10/26 8" @ 170'

Drlg. 2170'

11/3 "

11/10 Drlg 3255'

11/16 "

11/23 TD 3864'

Lansing 342 0'

Viola 3728'

Simpson 3786'

Arb. 3855'


Aband.

ABANDONED

Map No. _____ Sec. 33 Twp. 23 R. 12WWell No. 1 HeyenCrown Oil CompanyFIRST REPORT Contractor

NE SW

SECTION PLAT

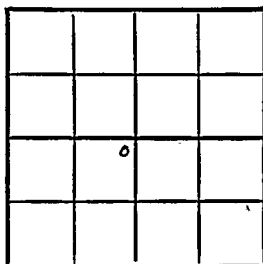330 Ft. from N. Line Ft. from S. Line330 Ft. from E. Line Ft. from W. Line

Stafford County

Location _____

Rig up _____

Drilling and Remarks:

R U R

RECORD

Cased _____ in., _____ ft.

Sand _____

Gas _____

Oil _____

Total Depth _____

PRODUCTION

1st 24 hrs. Nat. _____

1st 24 hrs. after shot _____

Gas _____ Cu. Ft.

Dry Hole _____

Abandoned _____

Date

OCT 20 1948 19S. J. LEWIS

Scout

Kansas

Map No. 47 Sec. 33 Twp. 23 R. 12WWell No. 1 Heven


Crown Oil

Company

ABANDONED

Contractor

NE SW

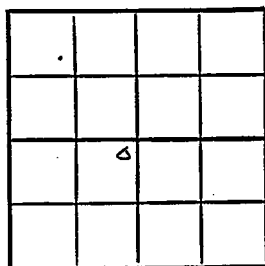E. 1/4
SECTION PLAT330 Ft. from N. Line

Ft. from S. Line

330 Ft. from E. Line

Ft. from W. Line

Stafford County

Location

Rig up

Drilling and Remarks:

Lane 3420
Vista 3725
Sing 3786
Art 3855

RECORD

Cased _____ in., _____ ft.

Sand _____

Gas _____

Oil _____

Total Depth 3864

PRODUCTION

1st 24 hrs. Nat. _____

1st 24 hrs. after shot _____

Gas _____ Cu. Ft.

Dry Hole _____

Abandoned _____

Date

NOV 23 1942

19

S. J. LEWIS Scout