

KANSAS

Section 33 Township 23 Range 13-W

Well No. #2 Clair

Company Crown Oil

St. Johns Pool

NORTH

WEST

EAST

SOUTH

16

0

Sec. 33 Twp. 23 R. 13W

Well No. #2 Clair Farm

Crown Oil

Company

St. Johns Pool (Reserve Drlg. ^{NORTH} Contr.)

Ft. from N. Line


990'

Ft. from S. Line

990'

Ft. from E. Line

Ft. from W. Line

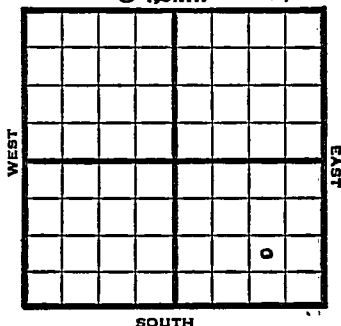

NW SE SE

1949 Elev. 1907' REPORT

11/16 Location

11/23 "

11/29 8" @ 327'

Drlg 2260'

12/7 Lansing 3194'

Drlg 3455'

12/14 Arbuckle 3937'

TD 3942'

5" @ 3937'

12/21 "

12/28 "

1950

1/25 8" @ 327'

5" @ 3937'

Heeb 3343'

Lans 3520'

Arb 3937'

P 50 BOPD, 3% wtr

T. D. 3942'

COMPLETED

Kansas

Map No. _____ Sec. 33 Twp. 23 R. 13WWell No. 2 ClairCrown Oil CompanyReserve Drlg. Contractor

NW SE SE

SECTION PLAT
FIRST REPORT

_____ Ft. from N. Line

990 Ft. from S. Line990 Ft. from E. Line

_____ Ft. from W. Line

			o

Stafford County

Location X

Rig up _____

Drilling and Remarks: _____

RECORD

Cased _____ in., _____ ft.

Sand _____

Gas _____

Oil _____

Total Depth _____

PRODUCTION

1st 24 hrs. Nat. _____

1st 24 hrs. after shot _____

Gas _____ Cu. Ft.

Dry Hole _____

Abandoned _____

Date

NOV 16 1949 19S. J. LEWIS Scout

Map No. _____ Sec. 33 Twp. 23 R. 13WWell No. 2 Clair

Crown Oil _____ Company

Contractor _____

NW SE SE

E1. 1907
SECTION PLAT

COMPLETE			
			o

_____ Ft. from N. Line

990 Ft. from S. Line990 Ft. from E. Line

_____ Ft. from W. Line

Stafford County

RECORD

Location _____

Cased _____ in., _____ ft.

Rig up _____

Sand _____

Drilling and Remarks:

Gas _____

8" @ 327

Oil _____

Total Depth ~~377~~ 39425" @ 3937Neib 3343Lane 3520Arb 3937P 50 BOPD3% wtr f

PRODUCTION

1st 24 hrs. Nat. _____

1st 24 hrs. after shot _____

Gas _____ Cu. Ft.

Dry Hole _____

Abandoned _____

Date

JAN 25 1950

19

J. E. TYRA
Scout