

# KANSAS


FORM 51 5M PETROL

Stafford

Section 33 Township 23 Range 13W

Well No. #2 Delker

Company Stanolind

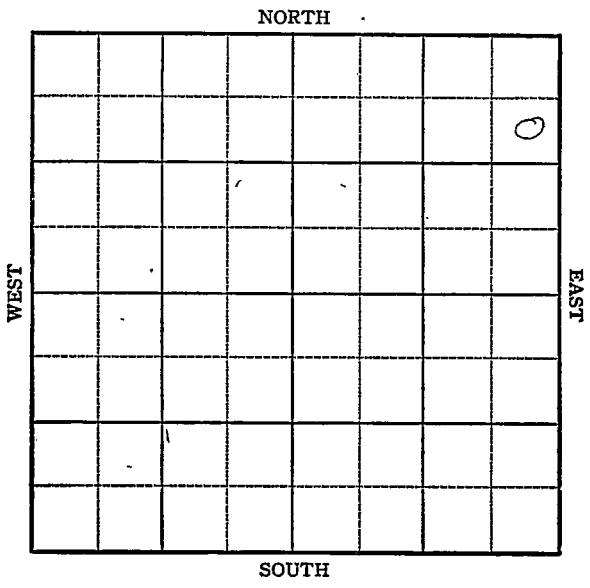

Sec. 33 Twp. 23 R. 13-W

Well No. #2 Delker Farm  
Stanolind Company  
(St. John)


990 Ft. from N. Line

         Ft. from S. Line

330 Ft. from E. Line

         Ft. from W. Line

*Elv. 1900*

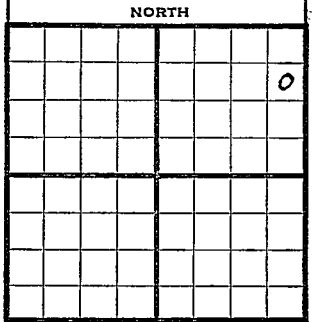

1944

REPORT

5/17

Rotary

5/24

8" @ 290  
Drlg. 2250

5/31

Drlg. 3560  
Lans 3495

6/10

Arb. 3917  
Had show, saturation and porosity  
5" - 3918  
T.D. 3922  
Bailing mud - getting ready to  
drill cement (Tel)

6/20

Arbuckle 3917  
Total Depth 3922  
5" - 3918  
1000 acid  
Depthograph Pot. 5638 bbls  
This is a better well than their #1.  
35.5 Gr. (Tel)

**COMPLETED**

**KANSAS**Pool Name St. JohnMap No. 83 Sec. 33 Twp. 23 R. 13WWell No. 2 DelkerStanolind

Company

**FIRST REPORT**

Contractor

SE NE NE

**SECTION PLAT**990

Ft. from N. Line

Ft. from S. Line

330

Ft. from E. Line

Ft. from W. Line

			o

Stafford County

Location \_\_\_\_\_

Rig up \_\_\_\_\_

Drilling and Remarks:

Rotary

**RECORD**

Cased \_\_\_\_\_ in., \_\_\_\_\_ ft.

Sand \_\_\_\_\_

Gas \_\_\_\_\_

Oil \_\_\_\_\_

Total Depth \_\_\_\_\_

**PRODUCTION**

1st 24 hrs. Nat. \_\_\_\_\_

1st 24 hrs. after shot \_\_\_\_\_

Gas \_\_\_\_\_ Cu. Ft.

Dry Hole \_\_\_\_\_

Abandoned \_\_\_\_\_

Date

MAY 17 1944 19

S. J. LEWIS Scout

**KANSAS**

Pool Name St. John

Map No. 73 Sec. 33 Twp. 23 R. 13W

Well No. 2 Delker

Stanolind Company

**COMPLETED** Contractor

SE NE NE

**SECTION PLAT**

990 Ft. from N. Line

         Ft. from S. Line

330 Ft. from E. Line

         Ft. from W. Line

			o

**Stafford County**

Location                                 

Rig up                                 

Drilling and Remarks:

*Cor 43917*

*5' 10 39 17*

*1000 acid*

*Dept 16 P 45638*

*355-4*

**RECORD**

Cased          in.,          ft.

Sand                                 

Gas                                 

Oil                                 

Total Depth 3922

**PRODUCTION**

1st 24 hrs. Nat.                                 

1st 24 hrs. after shot                                 

Gas                                  Cu. Ft.

Dry Hole                                 

Abandoned                                 

Date

JUN 21 1944 19

S. J. LEWIS Scout