

KANSAS


FORM 51 5M BR1X

Stafford

Section 33 Township 23 Range 13W

Well No. #3 Delker

Company Stanolind

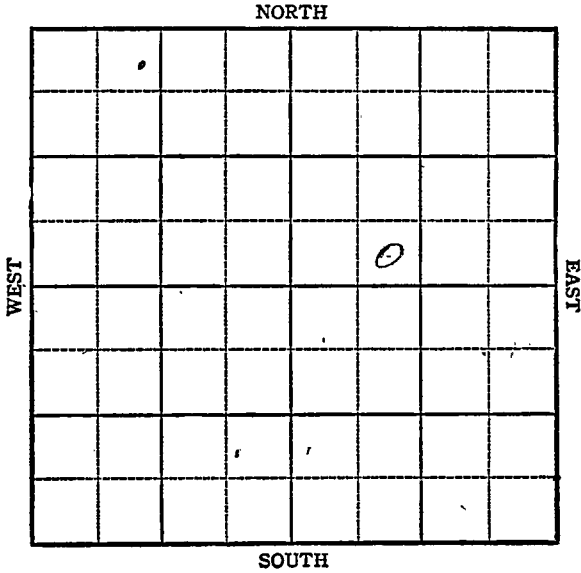

KANSAS

Stafford

Sec. 33 Twp. 23 R. 13W

Well No. #3 / Delker Farm
Stanolind Company

St. Johns

NORTH

_____ Ft. from N. Line

330' Ft. from S. Line

_____ Ft. from E. Line

990' Ft. from W. Line

WEST

EAST

SOUTH

Elev. 1904

1944

REPORT

6/21 Location

6/28 Surface hole.

7-12 Drilling 3455'

7-19 Lens 3502'

Simp. 3888' SO' SO

Arb. 3920'

TD 3927' SO

5" at 3920'

RUST

7-26 "

8-2 "

8/16

Arb 3920

5" @ 3920.

1000 Acid

TD - 3925

Depth Pot 6292

No W.

Max 3000

Gravity 38.0.

COMPLETE

KANSAS

Pool Name St. Johns

Map No. 83 Sec. 33 Twp. 23 R. 13W

Well No. 3 Delker

Stanolind Company

FIRST REPORT

Contractor

SE SW NE

SECTION PLAT

 Ft. from N. Line

330 Ft. from S. Line

 Ft. from E. Line

990 Ft. from W. Line

		.	
		o	

Stafford County

Location X

Rig up

Drilling and Remarks:

RECORD

Cased in., ft.

Sand

Gas

Oil

Total Depth

PRODUCTION

1st 24 hrs. Nat.

1st 24 hrs. after shot

Gas Cu. Ft.

Dry Hole

Abandoned

Date

JUN 21 1941 19

S. J. LEWIS Scout

