

KANSAS

FORM 51, 5M BRIX

Stafford

Section 33 Township 23 Range 13W

Well No. #1 St. Johns Townsite

Company Stanolind

						0	

NORTH

WEST

EAST

SOUTH

9

KANSAS

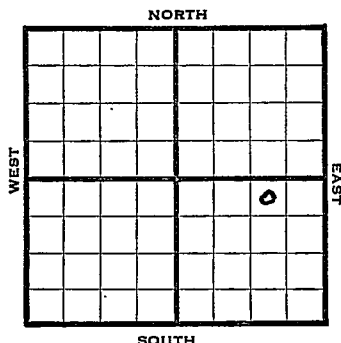
Stafford County

Sec. 33 Twp. 23 R. 13WWell No. #1 St. Johns Townsite FarmStanolind Company

St. Johns Townsite

330 Ft. from N. Line Ft. from S.-Line990 Ft. from E. Line Ft. from W. Line

NW NE SE



1944

REPORT

8/9

Loc.

8/16

"

8/23

Surface Hole

8/30

8" @ 288

Drlg. 2275

9/8

Drlg. 3810

9/13

Lans 3503

Simp 3868

Arb 3923

TD 3929 5" @ 3926 RUST

9/21

1000 acid swb 12 oil per hr 3 hrs
2000 acid

9/28

TD 3931 PB 3927 trace oil No WTr.

10/4

1200 acid Pump $2\frac{1}{2}$ fluid per hr 3%
wtr.

10/11

Arb. 3923'

5" @ 3926

PB 3928'

TD 3931'

4200 acid.

Pump 178 oil plus 3% water.

Pot.

36.0 gravity

COMPLETED

Pool Name St. Johns town-
siteMap No. KANSAS Sec. 33 Twp. 23 R. 13WWell No. 1 St. Johns TownsiteStanolind

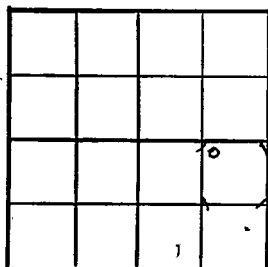
Company

FIRST REPORT

Contractor

NW NE SE

SECTION PLAT

330 Ft. from N. Line Ft. from S. Line990 Ft. from E. Line Ft. from W. LineStafford CountyLocation XRig up Drilling and Remarks:

RECORD

Cased in., ft.Sand Gas Oil Total Depth

PRODUCTION

1st 24 hrs. Nat. 1st 24 hrs. after shot Gas Cu. Ft.Dry Hole Abandoned

Date

AUG 9 194419S. J. LEWIS

Scout

Pool Name St. Johns TownsiteMap No. 83 Sec. 33 Twp. 23 R. 13WWell No. 1 St. Johns TownsiteStanolind

Company

COMPLETED

Contractor

NW NE SE

SECTION PLAT

330

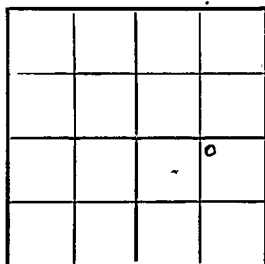
Ft. from N. Line

Ft. from S. Line

990

Ft. from E. Line

Ft. from W. Line

Stafford County

Location

Rig up

Drilling and Remarks:

*CE 83923**5" 03926**PB 8928**4200 acid**Pump 178 oil + 8 to 10**Bot.**362 ft*

RECORD

Cased _____ in. _____ ft.

Sand _____

Gas _____

Oil _____

Total Depth 8831

PRODUCTION

1st 24 hrs. Nat. _____

1st 24 hrs. after shot _____

Gals. _____ Cu. Ft.

Dry Hole _____

Abandoned _____

Date

OCT 11 1944S. J. LEWIS Scout