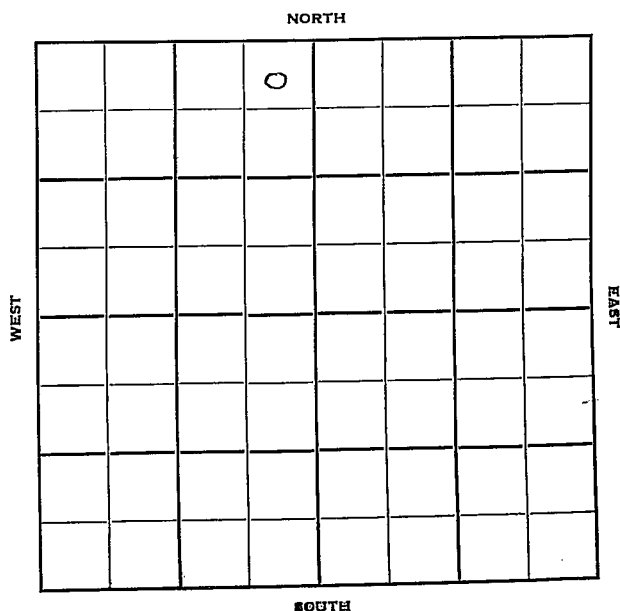


Section 33 Township 23 Range 11WWell No. #1 Gilmore Est.Company Palmer Oil

Stafford

KANSAS

Sec. 33 Twp. 23 R. 14 W ✓

Well No. # 1 Gilmore Est. Farm

Palmer Oil Company


Wildcat Contractor

330 Ft. from N. Line

Ft. from S. Line

330 Ft. from E. Line

Ft. from W. Line

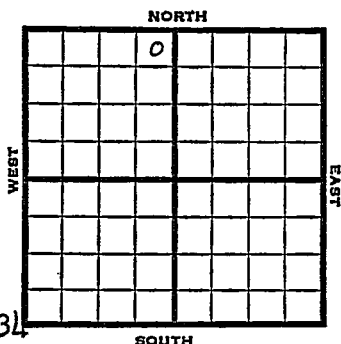

NE NE NW

MCPG has SW & W $\frac{1}{2}$ W $\frac{1}{2}$ SE 34

1951 Elev. 1969: REPORT

8/8 Spud 8-1-51
8" @ 282
Anhy 880'
Drlg. 3130'

8/20 Heebner 3457'
Brown Lime 3597'
K.C. 3612'
B KC 3865'
Cong. 3964'
Drilling 4000'. (L R)

8/24 Simp. 4036'
DST. 4030'-60' - open $\frac{1}{2}$ hr.
Rec. 12' slightly oil cut mud
Arb. 4081'-4104'
TD. 4104' - D & A. "

8/22 Spud 8-1-51
D&A TD 4104'
8" @ 282 Anhy 880
Heeb. 3457 Br lime 3597
KC 3612 BKC 3865
Cong 3964 Simp 4036
DST 4030-60 opn $\frac{1}{2}$ hr Rec. 12' socm
Arb. 4081-4104
D&A

ABANDONED

County Stafford State Kansas

Sec. 33 (^{Blk.}Twp.) 23 (^{Sur.}Rge.) 14W Map No.

Operator Palmer Oil

Well No. 1 Farm Gilmore Est.

Elev. Location NW NW NW

330 Ft. From N Line NW

330 Ft. From N Line Quarter

1st. Report AUG 8 1951

Completion

Remarks

MCPC has SW & W $\frac{1}{2}$ W $\frac{1}{2}$ SE 34


Spudding Date 8-1-51

Drlg. Data Wildcat

8" @ 282 Anhy 880 drlg. 3130

J. E. TYRA

County Stafford State Kansas
 Sec. 33 (Blk. 23 (Sur. 14W Map No.
 (Twp.) (Rge.)
 Operator Palmer Oil
 Well No. 1 Farm Gilmore Est.
 Elev. 1969 Location NE NE NW

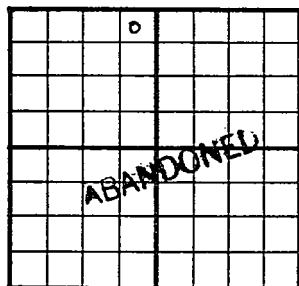

330 Ft. From N Line NW
330 Ft. From E Line Quarter
 Ist. Report
 Completion AUG 22 1951
 Remarks Wildcat

Spudding Date 8-1-51

Drlg. Data D & A TD 4104
8" @ 282 Anhy 880 Heeb. 3457
Br. lime 3597 KC 3612 B KC 3865
Cong. 3964 Simp. 4036 DST 4030-60
open $\frac{1}{2}$ hr. Rec. 12' socm Arb. 4081-4104
D & A

J. E. TYRA