


Section 33 Township 23 Range 15W

Well No. #1 Becker "D"

Company Cities Service Oil

NORTH

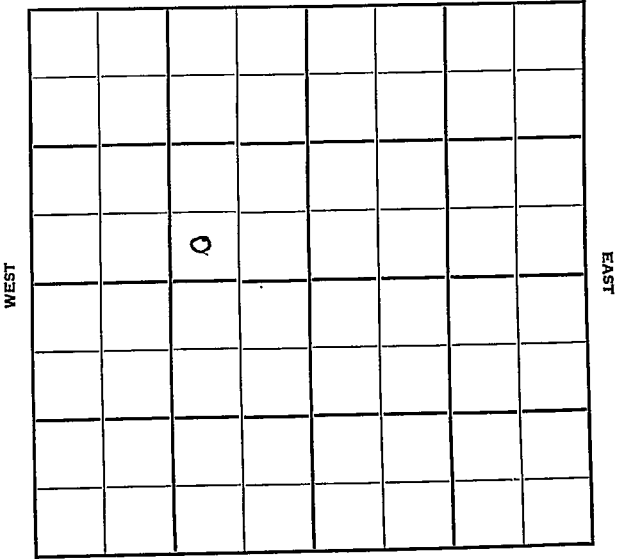

SOUTH

Pawnee

KANSAS

Sec. 33 Twp. 23 R. 15W

Well No. #1 Becker "D" Farm

Cities Service Oil Company


Wildcat Contractor

         Ft. from N. Line

330 Ft. from S. Line

990 Ft. from E. Line

         Ft. from W. Line  
SW SE NW

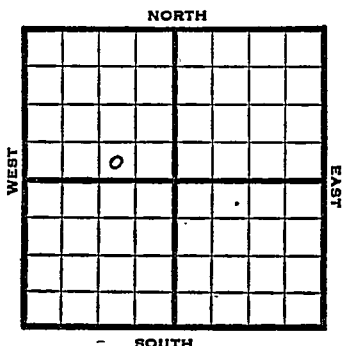

1952 Elev. 2026' REPORT

10/1 Location  
10/8 8" @ 375'  
-- Drlg. 1665'  
10/15 Drlg. 3653'  
10/22 Spud 10-3-52  
D & A TD 4160' 8" @ 375'  
Heeb 3503' Dodge 3521' Br. line  
3637' Lans. 3646'  
DST 3672-83 open 1 hr. rec 1000' SW  
800# B KC 3893' Viola 3976'  
Arb. 4144'  
DST 4146-60 open 1 hr. rec 2010' SW  
1320# TD 4160' D & A

**ABANDONED**



