


Section 33 Township 23 Range 33W

Well No. # 1 Needham

Company Northern Pump

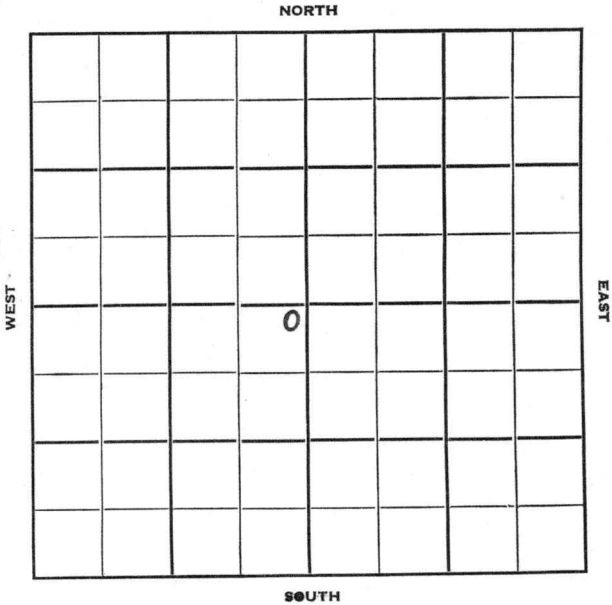

Sec. 33 Twp. 23 R. 33 W

Well No. # 1 Needhom Farm

Northern Pump Company

Contractor


150 Ft. from N. Line

Ft. from S. Line

150 Ft. from E. Line

Ft. from W. Line

NE NE SW

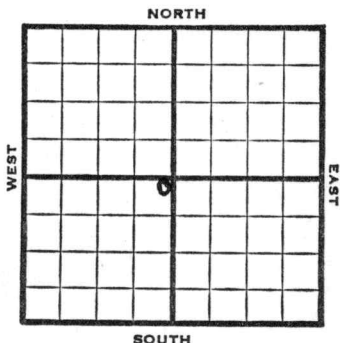

1952

Elev. 2905' REPORT

8/13

Spud 8-8-52
Set surf 10" @ 377

8/20

RTD 2550 7" @ 2540

8/27

DD 2596' 1000 A

9/3

DD 2638 TD 16,000 A

9/10

8000 A Her 2540 Winfield 2612

9/17

110' of Liner

9/24

NR

10/1

Spud 8-8-52
Gas Well TD 2638'
10" @ 377' 7" @ 2540
TD 2596' 1000 A DD 2638
16000 A Her. 2540 Win. 2612
Comp. 6,850,000 gas 385#


COMPLETED

County **Finney** State **Kansas**
 (Blk.)
 Sec. **33** (Twp.) **23** (Sur.) **33W** Map No.

Operator **Northern Pump**

Well No. **1** Farm **Needham**

Elev. Location **NE NE SW**

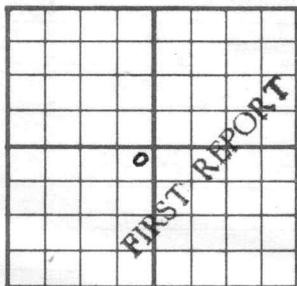

150 Ft. From **N** Line **SW**

150 Ft. From **E** Line Quarter

1st. Report **AUG 13 1952**

Completion

Remarks

Spudding Date **8-8-52**

Drlg. Data

Set surf 10" @ 377

J. G. McGEHEE

County	Finney		State	Kansas	
Sec.	33	(Blk. Twp.)	23	(Sur. Rge.)	33W Map No.

Sec. 33 (Blk. Twp.) 23 (Sur. Rge.) 33W Map No.

Operator Northern Pump

Well No. 1 Farm Needham

Elev.	2905	Location	NE	NE	SW
-------	------	----------	----	----	----

150 Ft. From N Line SW

150 Ft. From E Line Quarter

1st. Report

Completion OCT 1 1952

Remarks

Spudding Date 8-8-52

Drlg. Data Gas well TD 2638

10ⁱⁱ @ 377 7ⁱⁱ @ 2540 TD 2596 1000 A

DD 2638 16000 A Her. 2540 Win. 2612

Comp. 6,850,000 gas 385#

J. G. McGEHEE